

STATE ENGINEER
Salem, Oregon

MULT
1/28

Well Record

STATE WELL NO. 1N/2-14R
COUNTY MULTNOMAH
APPLICATION NO. GR-2705

OWNER: Joe Grosjacques


MAILING ADDRESS: 5720 NE 138th Ave.

LOCATION OF WELL: Owner's No.

CITY AND STATE: Portland, Oregon

SE 1/4 SE 1/4 Sec. 14 T. 1 N. R. 2 E., W.M.

Bearing and distance from section or subdivision corner 360' W & 160' N from SE corner Sec. 14

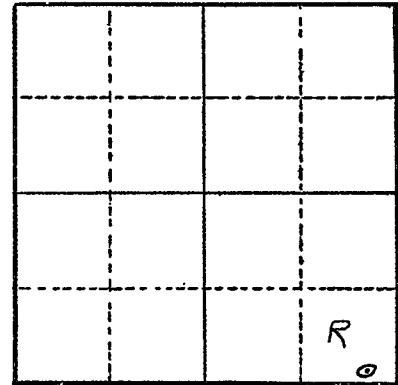

Section 14

Altitude at well

TYPE OF WELL: Drilled Date Constructed 1949

Depth drilled 65' Depth cased 65'

CASING RECORD:

6-inch

FINISH:

AQUIFERS: Silt & sand
Blue sand
Cement gravel
Loon water

WATER LEVEL:

20'

PUMPING EQUIPMENT: Type Fairbanks Morse H.P. 1 1/2

Capacity 50 G.P.M.

WELL TESTS:

Drawdown 7 ft. after 30 hours G.P.M.

Drawdown ft. after hours G.P.M.

USE OF WATER Irrigation Temp. °F. 19

SOURCE OF INFORMATION GR-3884

DRILLER or DIGGER

ADDITIONAL DATA:

Log Water Level Measurements Chemical Analysis Aquifer Test

REMARKS: Silt & sand 0' to 28'
Blue Sand 28' to 42'
Cement gravel 42' to 54'
Loon water bearing gravel 54' to 65'