
NOTICE TO WATER WELL CONTRACTOR The original and first copy of this report are to be filed with the

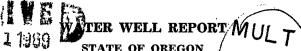

e Permit No.

STATE OF OREGON STATE ENGINEER, SALEM, OREGON STATE IS URE OF Please type or print) within 30 days from the date LEM. OREGON ont write above this line) of well completion. SALEM. OREGON

/		- 1		
			•	tate
	ITZ	X)
١,		9	٦	State
1	•			

(1) OWNER:	(11) LOCATION OF WELL:		
Name Mr. and Mrs. Louis A. Hopwood	County Multnomah Driller's well number		
Address 11031 N. E. Beech Portland, Oregon	14 14 Section 22 T. XINR. 2 E. W.M.		
(2) TYPE OF WORK (check):	Bearing and distance from section or subdivision corner		
	•		
New Well Deepening Reconditioning Abandon If abandonment, describe material and procedure in Item 12.			
	,		
(3) TYPE OF WELL: (4) PROPOSED USE (check):	(12) WELL LOG: Diameter of well below casing none		
Cable X Jetted Domestic Industrial Municipal	Depth drilled 180 ft. Depth of completed well 180 ft.		
Dug	Formation: Describe color, texture, grain size and structure of materials;		
CASING INSTALLED: Threaded Welded X Officer Diam. from 0 ft. to 176 ft. Gage 250	and show thickness and nature of each stratum and aquifer penetrated, with at least one entry for each change of formation. Report each change in position of Static Water Level as drilling proceeds. Note drilling rates.		
5 " Diam. from 172 ft. to 180 ft. Gage 10	MATERIAL From To SWL		
ft. Gage ft. Gage	Top Soil 1 5		
PERFORATIONS: Perforated? Ves Ves	Gravel & Boulders semi- 5 92		
e of perforator used Topch	Sand, fine - trace of 135 139		
Size of perforations 3/16 in. by 6 in.	Gravel & boulders 139 151		
30 perforations from 174 ft. to 179 ft.	Loose * minus 151 166		
perforations from ft. to ft.	Boulder 166 168		
perforations from ft, to ft.	Very sandy, gray binder 168 171		
perforations fromft. toft.	Gravel & sand 171 173		
perforations from ft. to ft.	<u>Water gravel</u> 173 178 131		
(7) SCREENS: Well screen installed? ☐ Yes XNo	Gravel with brown silt 178 180		
Manufacturer's Name			
Type Model No.			
Diam Slot size Set from ft. to ft.			
Diam. Slot size Set from ft. to ft.			
(8) WATER LEVEL: Completed well.			
Static level 131 ft. below land surface Date 6-12-69			
ian pressure lbs. per square inch Date			
9) WELL TESTS: Drawdown is amount water level is lowered below static level			
Was a pump test made? ☐ Yes X No If yes, by whom?			
Violet and Antonio	Work started 5-12 19 69 Completed 6-12 19 60		
gai./min. with ft. drawdown after hrs.	Date well drilling machine moved off of well $6-12$ 19 60		
" " "	Drilling Machine Operator's Certification:		
Bailer test 30 gal./min. with 1 ft. drawdown after 1 hrs.	This well was constructed under my direct supervision. Materials used and information reported above are true to my best		
Artesian flow g.p.m. Date	knowledge and belief		
Temperature of water 51 Was a chemical analysis made? Yes X No	[Signed]DateDate		
(10) CONSTRUCTION:			
Well seal—Material used <u>Cement</u>	Drilling Machine Operator's License No. 18		
Depth of seal90ft.	Water Well Contractor's Certification:		
Diameter of well bore to bottom of seal	This well was drilled under my jurisdiction and this report is		
Were any loose strata cemented off? Yes No Depth	true to the best of my knowledge and belief.		
Was a drive shoe used? ∑ Yes □ No	NAME Calvin C Prant, Well Type or print)		
Did any strata contain unusable water? Yes No			
Type of water? depth of strata	Address 17120 S.E. Foster Rd. Portland		
Method of sealing strata off	Oregon 97236		
Was well gravel packed? ☐ Yes 🎝 No Size of gravel:	[Signed] (Water Well Contractor)		
Gravel placed from ft. to ft.	Contractor's License No. 222 Date		
