



Oregon Water Resources Department
 725 Summer Street NE, Suite A
 Salem Oregon 97301
 (503) 986-0900
 www.wrd.state.or.us

Application for Well ID Number

Do not complete if the well already has a Well Identification Number.

RECEIVED

JUN 12 2014

WATER RESOURCES DEPT
 SALEM, OREGON

I. OWNER INFORMATION

Current Owner Name (please print): USACOE Bonneville Lock and Dam
 Mailing Address: I-84 East Exit 40
 City, State, Zip: Cascade Locks, Oregon, 97014
 Mail Well ID Tag to: SAME AS ABOVE In Care Of (C/O)
 Name & Address: Dolorus Pinaula, Bonneville Lock and Dam
 City, State, Zip: Cascade Locks Oregon 97014

II. WELL LOCATION INFORMATION (Please fill out as completely as possible)

Township: 2N (North / South) Range: 7E (East / West) Section: 21
 Tax Lot: G Lot 2 County Multnomah NE 1/4 SW 1/4
 GPS Coordinates: N 721.791.02, E 1.628.584.39
 Street Address of Well, City: I-84 E Exit 40 Bonneville Dam, Robins Island, Cascade Locks
 If the property had a different street address in the past: N/A

III. GENERAL WELL INFORMATION (Please fill out as completely as possible)

Use of Well (domestic, irrigation, commercial, industrial, monitoring): Fish Hatchery and Domestic Water
 Date Well Constructed (or property built): March 1990 Total Well Depth: 234.71 feet Casing Diameter: 20"
 Owner at time the well was constructed (if known): USACOE - Labelled as Well H-2/F-7 (WW 2087)
 Other Information: Driller Schneider Equipment, St. Paul, Oregon

SUBMITTED BY (please print): Kevin Perletti
 PHONE: 541-374-4572 EMAIL &/or FAX: kevin.p.perletti@usace.army.mil

Send application to: Oregon Water Resources Department 725 Summer St NE, Suite A, Salem, Oregon 97301; or fax to (503) 986-0902. Applications are processed in the order they are received, and Well ID Numbers are mailed within 4-5 business days.

For Official Use Only by the Oregon Water Resources Department:

Received Date:


6-12-14

Well Log Number:

MULT 116051

Well Identification #:

L-114945

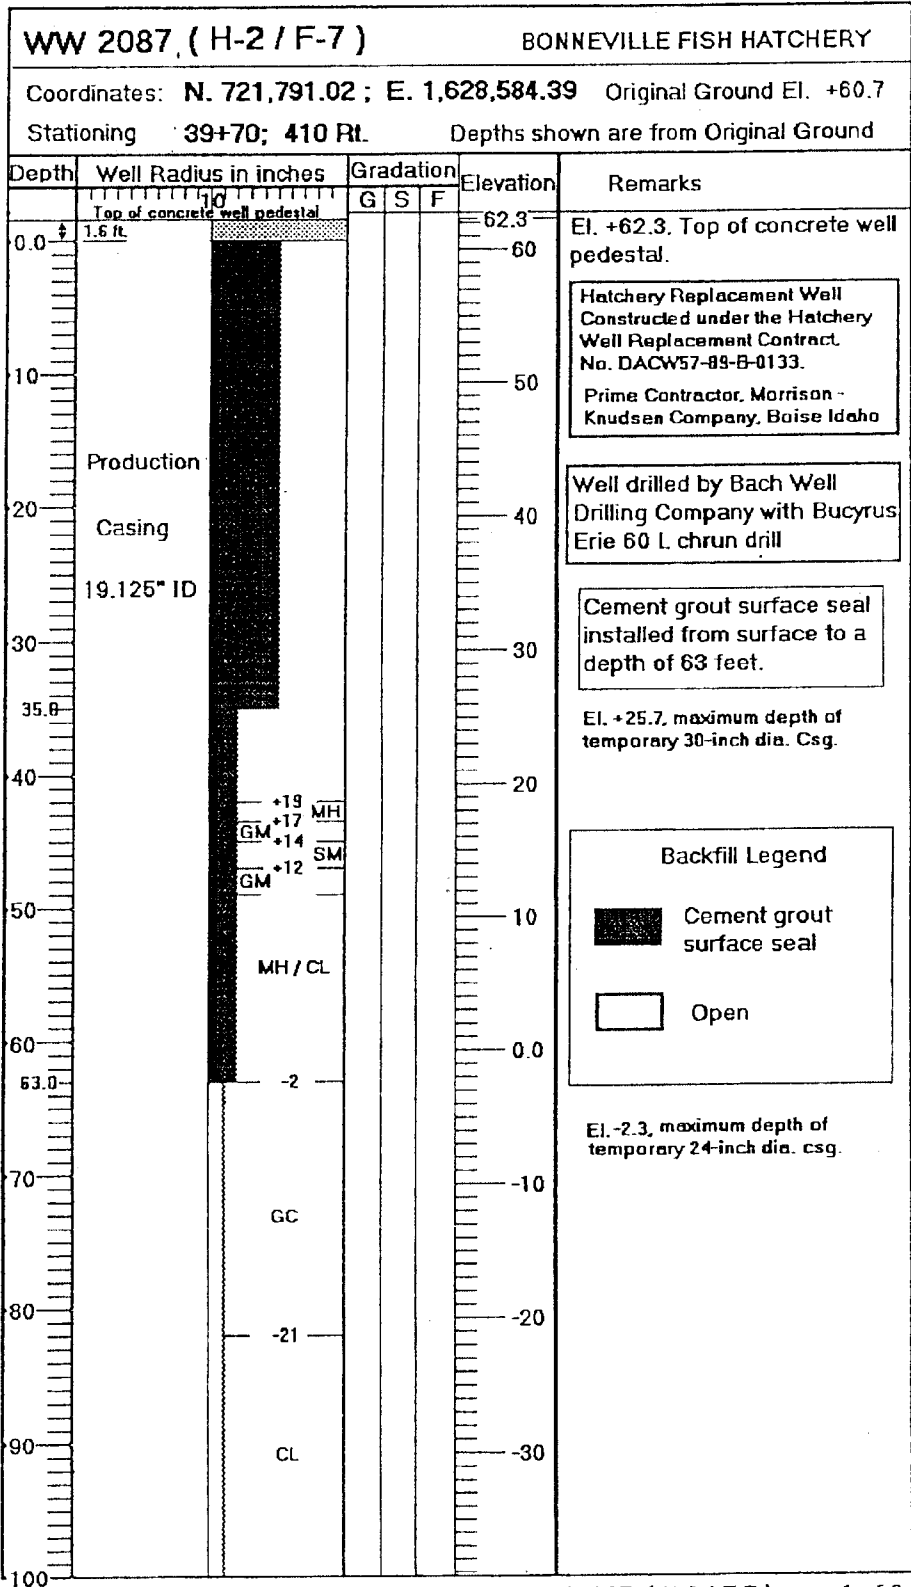



MK-Co.

MULT 116051

COMPANY

JOB TITLE BONN NEW NAV LOCK HATCH WELLS

CONTRACT NO. 3302

DESCRIPTION AS-BUILT FOR CONSTRUCTION OF

(DACW57-89-C-0117)

HATCHERY REPLACEMENT WELL F-7 (WW-2087)

SHEET NO. 01

MADE BY DALE E CONOVER

CHECKED BY

DATE 3/16/90

