

STATE ENGINEER
Salem, Oregon

Well Record

STATE WELL NO. 1N/2-23 A
COUNTY MULTNOMAN
APPLICATION NO. GR-2704

MULT
1202

OWNER: Joe Grosjacques


MAILING ADDRESS: 5720 NE 138th AVE

LOCATION OF WELL: Owner's No. 1

CITY AND STATE: Portland, Oregon

NE ¼ NE ¼ Sec. 23 T. 1 N. 8, R. 2 E. 1, W.M.

Bearing and distance from section or subdivision corner 200' W and 560' S from NE corner Sec 23

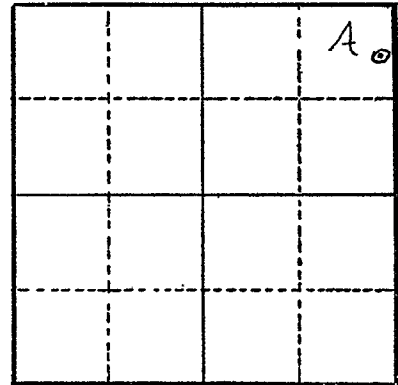

Section 23

Altitude at well _____

TYPE OF WELL: Drilled Date Constructed 1950

Depth drilled 55' Depth cased 55'

CASING RECORD:

12-inch

FINISH:

AQUIFERS:

WATER LEVEL:

12'

PUMPING EQUIPMENT: Type Jucuzzi Centrifugal H.P. 10
Capacity 300 G.P.M.

WELL TESTS:

Drawdown 10 ft. after _____ hours 300 G.P.M.
Drawdown _____ ft. after _____ hours _____ G.P.M.

USE OF WATER Irrigation Temp. _____ °F. _____, 19____

SOURCE OF INFORMATION GR-3883

DRILLER or DIGGER _____

ADDITIONAL DATA:

Log Water Level Measurements _____ Chemical Analysis _____ Aquifer Test _____

REMARKS:

Soil & silt	0'	to 32'
Boulder & silt	32'	to 36'
Sandy	36'	to 39'
Gravel & some sand	39'	to 47'
Sand alone	47'	to 49'
Sand & gravel	49'	to 55'