

STATE ENGINEER  
Salem, Oregon

# MULT Well Record

STATE WELL NO. 1N/3-21P  
COUNTY Multnomah  
APPLICATION NO. GR-3915

001304

OWNER: Interlachen, Inc.


MAILING ADDRESS: Route 2, Box 289

LOCATION OF WELL: Owner's No. \_\_\_\_\_

CITY AND STATE: Troutdale, Oregon

SE 1/4 SW 1/4 Sec. 21 T. 1 N. 3 E. W, W.M.

Bearing and distance from section or subdivision corner 250' W. & 1200' N. from S<sup>1</sup> Cor. Sec. 21

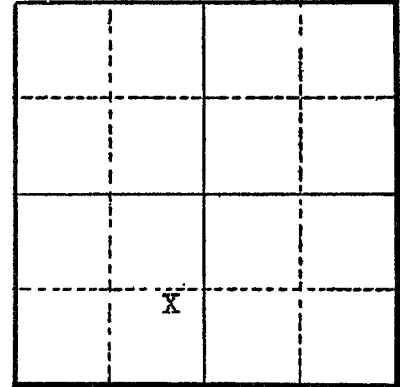

Section 21

Altitude at well \_\_\_\_\_

TYPE OF WELL: Drilled Date Constructed 4/42

Depth drilled 109 ft. Depth cased 109 ft.

### CASING RECORD:

8 inch casing from 1 to 109 feet

### FINISH:

### AQUIFERS:

### WATER LEVEL:

11 feet below surface

PUMPING EQUIPMENT: Type 2" x 2 1/2" Advance jet H.P. 2  
Capacity 30 G.P.M.

### WELL TESTS:

Drawdown 59 ft. after \_\_\_\_\_ hours 33 G.P.M.  
Drawdown 104 ft. after \_\_\_\_\_ hours 59 G.P.M.

USE OF WATER Municipal Temp. \_\_\_\_\_ °F. \_\_\_\_\_, 19\_\_\_\_

SOURCE OF INFORMATION Well Registration Statement Cert. # GR-3766

DRILLER or DIGGER O. B. Olson

### ADDITIONAL DATA:

Log \_\_\_\_\_ Water Level Measurements \_\_\_\_\_ Chemical Analysis \_\_\_\_\_ Aquifer Test \_\_\_\_\_

### REMARKS: