

STATE ENGINEER
Salem, Oregon

MULT
001306

Well Record

GR- 1589

STATE WELL NO. 1N/3-22H
COUNTY Multnomah
APPLICATION NO. GR- 1443

OWNER: Fairview Farms Inc.

MAILING ADDRESS: Rt. 2, Box 40

LOCATION OF WELL: Owner's No. #6

CITY AND STATE: Troutdale, Oregon


SE 1/4 NE 1/4 Sec. 22 T. 1 N. E. S, R. 3 W., W.M.

Bearing and distance from section or subdivision corner For location see sketch on map -----

Altitude at well 26'

TYPE OF WELL: Drilled Date Constructed 1950

Depth drilled 200' Depth cased 200'

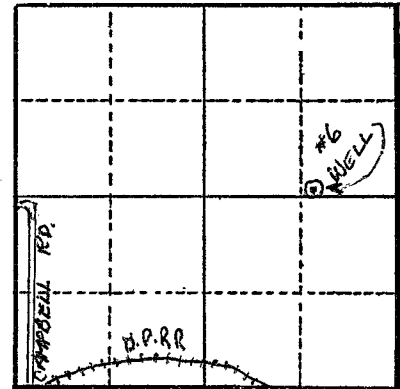

Section 22

CASING RECORD:

- 18" from 0 to 140 ft.
- 12" from 119 to 200 ft.

FINISH:

Perforated from 119 to 200 ft.

AQUIFERS:

WATER LEVEL:

17'

PUMPING EQUIPMENT: Type Peerless turbine H.P. 75

Capacity 1200 G.P.M.

WELL TESTS:

Drawdown	12	ft. after	hours	1200	G.P.M.
Drawdown	14	ft. after	hours	1500	G.P.M.

USE OF WATER Dom., Irrigation & Manuf. Temp. °F. , 19

SOURCE OF INFORMATION GR Record

DRILLER or DIGGER

ADDITIONAL DATA:

Log Water Level Measurements _____ Chemical Analysis _____ Aquifer Test _____

REMARKS: Irrigation of 170 acres.

- Log: Top soil & yellow clay 0 to 16 ft.
- Yellow sand 16 to 27 ft.
- Blue quicksand 27 to 49 ft.
- Fine gray sand 49 to 82 ft.
- Brown silt 82 to 94 ft.
- Fine gray sand - gray clay binder 94 to 136 ft.
- Coarse sand - small gravel - gray clay binder 136 to 158 ft.
- Coarse sand - small gravel - water bearing 158 to 183 ft.
- Fine gray sand - gray clay binder 183 to 196 ft.
- Gray silt 196 to 200 ft.