

STATE ENGINEER
Salem, Oregon

MULT
001308

Well Record

STATE WELL NO. 1N/3-23F(1)
COUNTY Multnomah
APPLICATION NO. GR- 462

OWNER: Reynolds Metals Co.

MAILING ADDRESS: Sundial Rd.


LOCATION OF WELL: Owner's No. 1

CITY AND STATE: Troutdale, Oregon

SE 1/4 NW 1/4 Sec. 23 T. 1 N. 3 E. W.M.

Bearing and distance from section or subdivision

corner N.37°09'W. 2732' from SE cor. of sec. 23

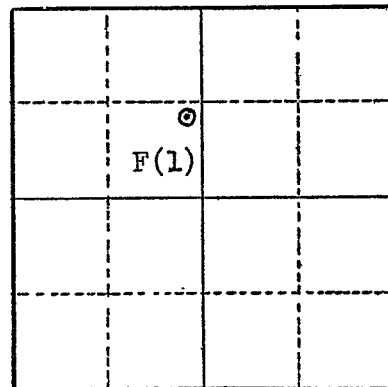

Altitude at well 26'

TYPE OF WELL: Drilled Date Constructed May 1942

Depth drilled 282' Depth cased 282'

Section 23

CASING RECORD:
12 inch

FINISH:

AQUIFERS:

WATER LEVEL:
85 feet

PUMPING EQUIPMENT: Type Pamona 7 stage turbine H.P. 50
Capacity 735 G.P.M.

WELL TESTS:
Drawdown ft. after hours G.P.M.
Drawdown ft. after hours G.P.M.

USE OF WATER Industrial Temp. °F. 19

SOURCE OF INFORMATION GR- 445

DRILLER or DIGGER

ADDITIONAL DATA:

Log X Water Level Measurements Chemical Analysis Aquifer Test

REMARKS:

State Well No. 1N/3-23FD)
County Mt.
Application No. GR-462

Owner: Reynolds Metals Co. Owner's No. #1
Driller: — Date Drilled Feb. 23, '42

[illegible]