

STATE ENGINEER
Salem, Oregon

MULTI-Well Record

STATE WELL NO. 1N/3-23G(8)
COUNTY Multnomah
APPLICATION NO. GR-462

OWNER: Reynolds Metals Co.


MAILING
ADDRESS: Sundial Rd.

LOCATION OF WELL: Owner's No. 14

CITY AND
STATE: Troutdale, Oregon

SW $\frac{1}{4}$ NE $\frac{1}{4}$ Sec. 23 T. 1 N. 3 E. W, W.M.

Bearing and distance from section or subdivision
corner 2839' N. & 1334' W. from SE cor. sec. 23

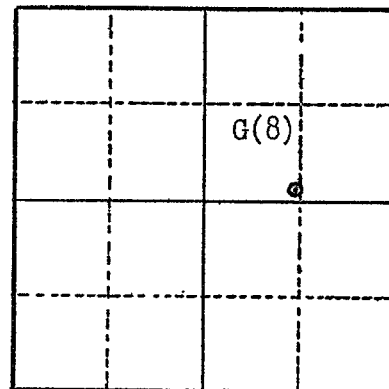

Section 23

Altitude at well 28.5'

TYPE OF WELL: Drilled Date Constructed 9/29/49

Depth drilled 644' Depth cased 644'

CASING RECORD:

20 inch from 0 to 144 feet

12 inch from 0 to 644 feet

FINISH:

Perforated from 150 to 189 feet - shut off when well was redrilled to 644 feet.
(7/20/55)

AQUIFERS:

WATER LEVEL:

49 feet

PUMPING EQUIPMENT: Type Peerless turbine H.P. 60
Capacity 1180 G.P.M.

WELL TESTS:

Drawdown 100 ft. after 1050 hours G.P.M.

Drawdown ft. after hours G.P.M.

USE OF WATER Industrial Temp. °F. 19

SOURCE OF INFORMATION GR-445

DRILLER or DIGGER

ADDITIONAL DATA:

Log X Water Level Measurements Chemical Analysis Aquifer Test

REMARKS:

STATE ENGINEER
Salem, Oregon

State Well No. 1419-230(7)
County Mult.
Application No. GP-462

Well Log

Owner: Reynolds Metals Co. Owner's No. # 19
Driller: ✓ Date Drilled Sept. 29, 197

CHARACTER OF MATERIAL	(Feet below 'and surface)		Thickness (feet)
	From	To	
Dredge sand from river	0	5	5
Brown silt	5	16	11
Brown clay	16	24	8
Runny blue silt	24	35	11
Sticky blue clay	35	42	7
Fine gray sand	42	96	54
Cemented sand & gravel, hard	96	118	22
Hard blue clay	118	124	6
Fine gray sand-gray clay binder	124	146	22
Coarse black sand	146	152	6
Coarse sand, fine gravel - water bearing formation	152	184	32
Fine sand-gray clay binder	184	191	7
Gray silt	191	194	3
Sandy silt	194	215	21
Packed sand	215	224	9
Silt	224	233	9
Sand & clay	233	239	6
Cemented gravel	239	247	8
Sand & gravel w/ some clay binder	247	287	40
Packed sand	287	307	20
Gravel & sandy clay	307	332	25

Owner: Reynolds Metals Co. Owner's No. # 14

STATE ENGINEER
Salem, Oregon

MULT 1310
Well Record

STATE WELL NO. 1N/3-23G(8)
COUNTY Multnomah
APPLICATION NO. GR-462

OWNER: Reynolds Metals Co.

MAILING ADDRESS: Sundial Rd. 23acdd


LOCATION OF WELL: Owner's No. 14

CITY AND STATE: Troutdale, Oregon

SW 1/4 NE 1/4 Sec. 23 T. 1 N. R. 3 E. W.M.

Bearing and distance from section or subdivision

corner 2839' N. & 1334' W. from SE cor. sec. 23

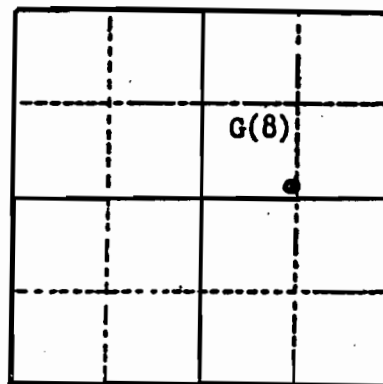

Altitude at well 28.5'

Section 23

TYPE OF WELL: Drilled Date Constructed 9/29/49

Depth drilled 644' Depth cased 644'

CASING RECORD:

20 inch from 0 to 144 feet

12 inch from 0 to 644 feet

FINISH:

Perforated from 150 to 189 feet - shut off when well was redrilled to 644 feet.
(7/20/55)

AQUIFERS:

WATER LEVEL:

49 feet

PUMPING EQUIPMENT: Type Peerless turbine H.P. 60
Capacity 1180 G.P.M.

WELL TESTS:

Drawdown 100 ft. after hours 1050 G.P.M.

Drawdown ft. after hours G.P.M.

USE OF WATER Industrial Temp. °F. 19

SOURCE OF INFORMATION GR-445

DRILLER or DIGGER

ADDITIONAL DATA:

Log X Water Level Measurements Chemical Analysis Aquifer Test

REMARKS:

RECEIVED

APR 15 1996

WATER RESOURCES DEPT.
SALEM, OREGON