

STATE ENGINEER
Salem, Oregon

MULT

001311

Well Record

STATE WELL NO. 1N/3-23H(3)
COUNTY Multnomah
APPLICATION NO. GR-462

OWNER: Reynolds Metals Co.

MAILING

ADDRESS: Sundial Rd.

LOCATION OF WELL: Owner's No. 6


CITY AND

STATE: Troutdale, Oregon

SE $\frac{1}{4}$ NE $\frac{1}{4}$ Sec. 23 T. 1 N. EX R. 3 XX W.M.

Bearing and distance from section or subdivision

corner 3559' N. & 1157' W. from SE cor sec. 23

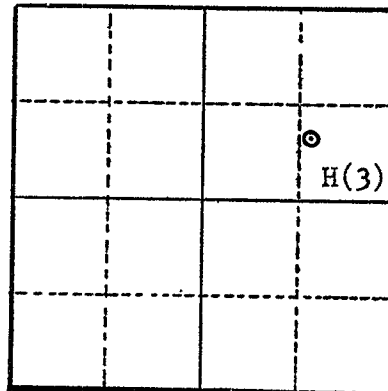

Altitude at well 28.5'

TYPE OF WELL: Drilled Date Constructed 2/27/48

Depth drilled 279' Depth cased 279'

Section 23

CASING RECORD:

18 inch from 0 to 193 feet

12 inch from 180 to 279 feet

FINISH:

AQUIFERS:

WATER LEVEL:

55 feet

PUMPING EQUIPMENT: Type F. M., 5 stage turbine H.P. 60
Capacity 1000 G.P.M.

WELL TESTS:

Drawdown _____ ft. after _____ hours _____ G.P.M.

Drawdown _____ ft. after _____ hours _____ G.P.M.

USE OF WATER Industrial Temp. _____ °F. _____, 19.

SOURCE OF INFORMATION GR-445

DRILLER or DIGGER _____

ADDITIONAL DATA:

Log X Water Level Measurements _____ Chemical Analysis _____ Aquifer Test _____

REMARKS:

STATE ENGINEER
Salem, Oregon

State Well No. 1413-23H(3)
County WV
Application No. CR-463

Well Log

Owner: Reynolds ^(metals) ~~Medals~~ Co. Owner's No. #6

Driller: _____ Date Drilled Feb. 27, '48

[illegible]