

STATE ENGINEER
Salem, Oregon

MULT
001312

Well Record

STATE WELL NO. 1N/3-23H(6)
COUNTY Multnomah
APPLICATION NO. GR- 462

OWNER: Reynolds Metals Co.

MAILING

ADDRESS: Sundial Rd.

LOCATION OF WELL: Owner's No. 15


CITY AND

STATE: Troutdale, Oregon

SE $\frac{1}{4}$ NE $\frac{1}{4}$ Sec. 23 T. 1 N. R. 3 E. W.M.

Bearing and distance from section or subdivision

corner 2964' N. & 654' W. from SE cor. sec. 23

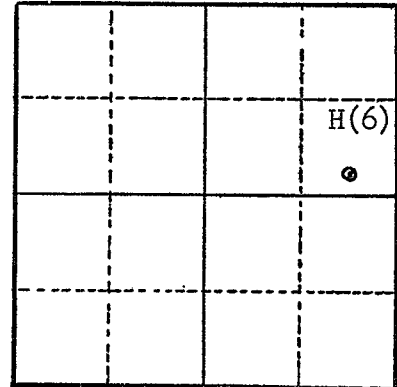

Altitude at well 28.5'

TYPE OF WELL: Drilled Date Constructed 4/30/53

Depth drilled 275' Depth cased 275'

Section 23

CASING RECORD:

20 inch from 0 to 242 feet

12 inch from 225 to 275 feet

FINISH:

AQUIFERS:

WATER LEVEL:

41 feet

PUMPING EQUIPMENT: Type F. M. Pamona turbine H.P. 75
Capacity 1200 G.P.M.

WELL TESTS:

Drawdown 51 ft. after _____ hours 1350 G.P.M.

Drawdown _____ ft. after _____ hours _____ G.P.M.

USE OF WATER Industrial Temp. _____ °F. _____, 19

SOURCE OF INFORMATION GR- 445

DRILLER or DIGGER _____

ADDITIONAL DATA:

Log X Water Level Measurements _____ Chemical Analysis _____ Aquifer Test _____

REMARKS:

State Well No. 1N/3-2346
County Mult.
Application No. GP-462

Owner: Reynolds Metals Co. Owner's No. #15
Driller: _____ Date Drilled April 30, '53

[illegible]