

STATE ENGINEER
Salem, Oregon

MULT Well Record
001320

STATE WELL NO. 1N/3-23G(4)
COUNTY Multnomah
APPLICATION NO. GR- 462

OWNER: Reynolds Metals Co.

MAILING
ADDRESS:

Sundial Rd.

LOCATION OF WELL: Owner's No. 10


CITY AND
STATE:

Troutdale, Oregon

SW 1/4 NE 1/4 Sec. 23 T. 1 N. 3 E. W. W.M.

Bearing and distance from section or subdivision

corner 3198' N. & 1754' W. from SE cor. sec. 23

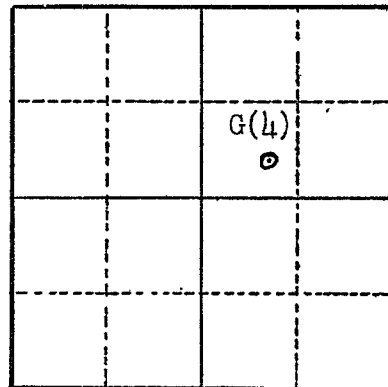

Altitude at well 28.5'

TYPE OF WELL: Drilled Date Constructed 8/17/49

Depth drilled 625' Depth cased 625'

Section 23

CASING RECORD:

20 inch from 0 to 140 feet

12 inch from 0 to 625 feet

FINISH:

Perforated from 144 to 185 feet - shut off when well was redrilled to 625'

AQUIFERS:

WATER LEVEL:

78 feet (1955)

PUMPING EQUIPMENT: Type Peerless, 3 stage turbine H.P. 60
Capacity 1180 G.P.M.

WELL TESTS:

Drawdown 40 ft. after 900 hours G.P.M.

Drawdown 48 ft. after 1100 hours G.P.M.

USE OF WATER Industrial Temp. °F. 19

SOURCE OF INFORMATION GR- 445

DRILLER or DIGGER

ADDITIONAL DATA:

Log X Water Level Measurements Chemical Analysis Aquifer Test

REMARKS:

STATE ENGINEER
Salem, Oregon

State Well No. IN/2-230(9)
County Mult.
Application No. GR-962

Well Log

Owner: Reynolds ^{Metals} Metals Co. Owner's No. #10

Driller: — Date Drilled Aug. 17 '49

CHARACTER OF MATERIAL	(Feet below 'and surface)		Thickness (feet)
	From	To	
Dredge sand from river	0	6	6
Brown sand	6	16	10
Blue clay	16	19	3
Brown sand	19	42	23
Gray sandy clay	42	62	20
Cemented gravel, gray binder	62	81	19
Gray silt & sand-water bearing	81	144	63
Gray sand-water bearing	144	165	21
Cemented gravel	165	168	3
Gray sand-water bearing	168	186	18
Gray silt	186	190	4
Blue sandy silt	190	206	16
Hard packed sand	206	227	21
Sandy silt	227	238	11
Coarse sand & gravel	238	244	6
Blue clay	244	252	8
Hard packed sand-some gravel	252	337	85
Sandy silt & gravel	337	342	5
Hard packed sand	342	372	30
Sandy clay	372	377	5
Hard packed sand & gravel	377	385	8
Sandy clay	385	392	7

State Well No. 14-3-2366
County Mult.
Application No. GR-462

Owner: Rex holds ^{Metals} ~~Medals~~ Co. Owner's No. #10

[illegible]