

STATE ENGINEER
Salem, Oregon

MULT Well Record

STATE WELL NO. 1N/3-23G(1)
COUNTY Multnomah
APPLICATION NO. GR- 462

OWNER: Reynolds Metals Co.

MAILING

ADDRESS: Sundial Rd.

LOCATION OF WELL: Owner's No. 2


CITY AND

STATE: Troutdale, Oregon

SW $\frac{1}{4}$ NE $\frac{1}{4}$ Sec. 23 T. 1 N. 3 E. W.M.

Bearing and distance from section or subdivision

corner N. 3749', W. 1950' from SE cor. of sec. 23

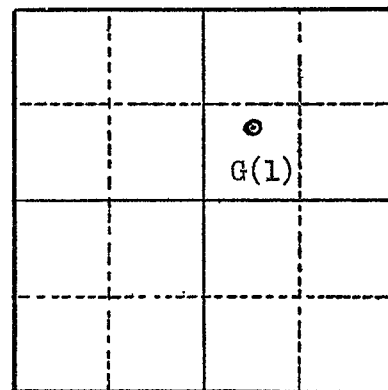

Altitude at well 26'

TYPE OF WELL: Drilled Date Constructed 2/23/42

Depth drilled 268' Depth cased 268'

Section 23

CASING RECORD:

10 inch

FINISH:

AQUIFERS:

WATER LEVEL:

78 feet

PUMPING EQUIPMENT: Type Pamona, 7 stage turbine H.P. 40
Capacity 530 G.P.M.

WELL TESTS:

Drawdown 22 ft. after 530 hours G.P.M.

Drawdown ft. after hours G.P.M.

USE OF WATER Industrial Temp. °F., 19.

SOURCE OF INFORMATION GR- 445

DRILLER or DIGGER

ADDITIONAL DATA:

Log X Water Level Measurements Chemical Analysis Aquifer Test

REMARKS:

State Well No. 11418-2360
County Mult.
Application No. GP-462

Owner: Reynolds ^{Metals} Metals Co. Owner's No. #2
Driller: _____ Date Drilled Feb. 23 '42

[illegible]