

STATE ENGINEER
Salem, Oregon

MULT

001323

Well Record

STATE WELL NO. 1N/3-23G(2)
COUNTY Multnomah
APPLICATION NO. GR- 462

OWNER: Reynolds Metals Co.

MAILING
ADDRESS:

Sundial Rd.

LOCATION OF WELL: Owner's No. 3


CITY AND
STATE:

Troutdale, Oregon

SW $\frac{1}{4}$ NE $\frac{1}{4}$ Sec. 23 T. 1 N. ~~34~~R. 3 E. ~~W~~W.M.

Bearing and distance from section or subdivision

corner 3674' N. & 1534' W. from SE cor. of sec. 23

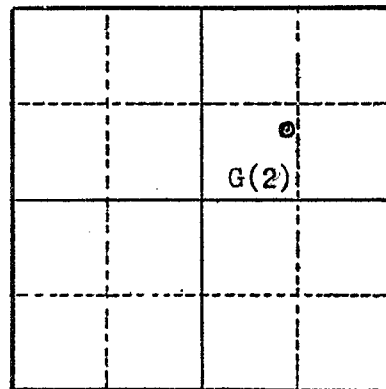

Section 23

Altitude at well 28.5'

TYPE OF WELL: Drilled Date Constructed June '42

Depth drilled 281' Depth cased 281'

CASING RECORD:

12 inch

FINISH:

AQUIFERS:

WATER LEVEL:

72 feet

PUMPING EQUIPMENT: Type Pamona, 4 stage turbine H.P. 40
Capacity 750 G.P.M.

WELL TESTS:

Drawdown 13 ft. after 600 hours G.P.M.

Drawdown ft. after hours G.P.M.

USE OF WATER Industrial Temp. °F. 19

SOURCE OF INFORMATION GR- 445

DRILLER or DIGGER

ADDITIONAL DATA:

Log X Water Level Measurements Chemical Analysis Aquifer Test

REMARKS:

STATE ENGINEER
Salem, Oregon

State Well No. 1N13-2900
County Mult.
Application No. GR-462

Well Log

Owner: Reynolds ^{Metals} Medals Co. Owner's No. #3

Driller: _____ Date Drilled June '42[illegible]