

STATE ENGINEER
Salem, Oregon

MULT
001324

Well Record

STATE WELL NO. 1N/3-23G(3)
COUNTY Multnomah
APPLICATION NO. GR-462

OWNER: Reynolds Metals Co.

MAILING
ADDRESS: Sundial Rd.


LOCATION OF WELL: Owner's No. 9

CITY AND
STATE: Troutdale, Oregon

SW $\frac{1}{4}$ NE $\frac{1}{4}$ Sec. 23 T. 1 N. 3 E. W., W.M.

Bearing and distance from section or subdivision

corner 3459' N. & 1744' W. from SE cor. sec. 23

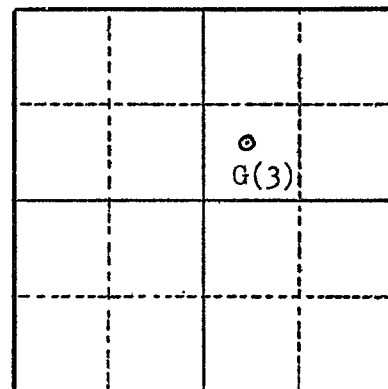

Section 23

Altitude at well 28.5'

TYPE OF WELL: Drilled Date Constructed 7/23/49

Depth drilled 295' Depth cased 295'

CASING RECORD:

20 inch from 0 to 136 $\frac{1}{2}$ feet
12 inch from 128 to 295 feet

FINISH:

AQUIFERS:

WATER LEVEL:

105 feet

PUMPING EQUIPMENT: Type Peerless, 2 stage turbine H.P. 10
Capacity 1200 G.P.M.

WELL TESTS:

Drawdown _____ ft. after _____ hours _____ G.P.M.

Drawdown _____ ft. after _____ hours _____ G.P.M.

USE OF WATER Industrial Temp. _____ °F. _____, 19 _____

SOURCE OF INFORMATION GR-445

DRILLER or DIGGER _____

ADDITIONAL DATA:

Log X Water Level Measurements _____ Chemical Analysis _____ Aquifer Test _____

REMARKS:

After development of well at 295' silt condition could not be remedied.
Well was back filled to 180' before pump test.

State Well No. 1N/3-236(3)
County Mult.
Application No. GR-462

Owner: Reynolds ^{Metals} Metals Co. Owner's No. #9
Driller: — Date Drilled July 23, '49

[illegible]