

STATE ENGINEER
Salem, Oregon

MULT Well Record

001325

STATE WELL NO. 1N/3-23G(5)
COUNTY Multnomah
APPLICATION NO. GR-462

OWNER: Reynolds Metals Co.

MAILING

ADDRESS: Sundial Rd.

LOCATION OF WELL: Owner's No. 11

CITY AND

STATE: Troutdale, Oregon

SW $\frac{1}{4}$ NE $\frac{1}{4}$ Sec. 23 T. 1 N. ~~S~~ R. 3 E. ~~W~~, W.M.


Bearing and distance from section or subdivision

corner 3246' N. & 1474' W. from SE cor. sec. 23

Altitude at well 28.5'

TYPE OF WELL: Drilled Date Constructed 8/17/49

Depth drilled 592' Depth cased 541'

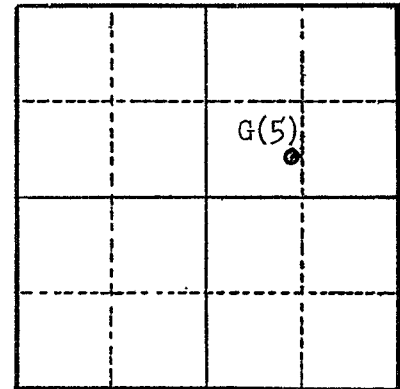

Section 23

CASING RECORD:

20 inch from 0 to 147 feet

12 inch from 0 to 541 feet

FINISH:

Perforated from 147 to 187 feet - shut off when well was redrilled to 592'
(2/16/55)

AQUIFERS:

WATER LEVEL:

45 feet

PUMPING EQUIPMENT: Type Peerless, 3 stage turbine H.P. 60
Capacity 1180 G.P.M.

WELL TESTS:

Drawdown 77 ft. after _____ hours 1000 G.P.M.

Drawdown 93 ft. after _____ hours 1200 G.P.M.

USE OF WATER Industrial Temp. _____ °F. _____, 19

SOURCE OF INFORMATION GR-445

DRILLER or DIGGER _____

ADDITIONAL DATA:

Log X Water Level Measurements _____ Chemical Analysis _____ Aquifer Test _____

REMARKS:

STATE ENGINEER
Salem, Oregon

State Well No. 1N13-236(5)
County Mult
Application No. CR-462

Well Log

Owner: Reynolds ^{metals} Metals Co. Owner's No. # 11

Driller: Date Drilled Aug. 17, '49

CHARACTER OF MATERIAL	(Feet below land surface)		Thickness (feet)
	From	To	
Dredge sand from river	0	8	8
Sandy clay	8	14	6
Brown clay	14	32	18
Brown silt	32	68	36
Brown silt & very fine gray sand	68	143	75
Hard brown silty clay	143	152	9
Gray sand & small gravel water bearing	152	167	15
Gray sand Cemented gravel	167	171	4
Gray sand-water bearing	171	178	7
Cemented gravel	178	183	5
Gray silt	183	188	5
Blue "	188	202	14
Gravel sandy clay binder	202	207	5
Sandy clay	207	219	12
Hard packed sand	219	232	13
Sandy silt	232	239	7
Hard packed sand - small amount gravel	239	274	35
Sandy silt.	274	286	12
Hard packed sand-some gravel	286	307	21
Silty sand-some gravel	307	362	55
Black shale	362	365	3

State Well No. 1N/3-236(5)
County MULT.
Application No. GP-462

Owner: Reynolds ^{Metals} Metals Co. Owner's No. #11
Driller: — Date Drilled —

[illegible]