

STATE ENGINEER
Salem, Oregon

MULT
001326

Well Record

STATE WELL NO. 1N/3-23G(6)
COUNTY Multnomah
APPLICATION NO. GR-462

OWNER: Reynolds Metals Co.


MAILING
ADDRESS: Sundial Rd.

LOCATION OF WELL: Owner's No. 12

CITY AND
STATE: Troutdale, Oregon

SW 1/4 NE 1/4 Sec. 23 T. 1 N. R. 3 E. W.M.

Bearing and distance from section or subdivision
corner 2944' N. & 1719' W. from SE cor. sec. 23

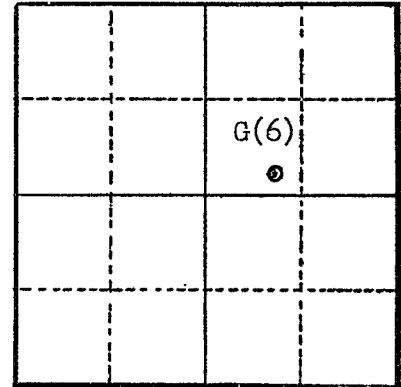

Altitude at well 28.5'

TYPE OF WELL: Drilled Date Constructed 9/13/49

Depth drilled 616' Depth cased 590'

Section 23

CASING RECORD:

20 inch from 0 to 140 feet
16 inch from 80 to 392 feet
12 inch from 0 to 590 feet

FINISH:

Perforated from 147 to 187 feet - shut off when well was redrilled on 3/18/54 to 616 feet. Hole backfilled with gravel from 616 to 584 feet to seal off fine sand strata from 598 to 607 feet.

AQUIFERS:

WATER LEVEL:

39 feet

PUMPING EQUIPMENT: Type Peerless, 3 stage turbine H.P. 60
Capacity 1180 G.P.M.

WELL TESTS:

Drawdown 71 ft. after 1000 hours G.P.M.
Drawdown 80 ft. after 1200 hours G.P.M.

USE OF WATER Industrial Temp. °F. 19

SOURCE OF INFORMATION GR-445

DRILLER or DIGGER

ADDITIONAL DATA:

Log X Water Level Measurements Chemical Analysis Aquifer Test

REMARKS:

STATE ENGINEER
Salem, Oregon

State Well No. 104-2562
County Mult.
Application No. GR-462

Well Log

Owner: Reynolds ^{metals} Metals Co. Owner's No. #12

Driller: _____ Date Drilled Sept. 13, '49

CHARACTER OF MATERIAL	(Feet below land surface)		Thickness (feet)
	From	To	
Dredge sand from river	0	5	5
Fine brown silt	5	19	14
Blue silt	19	26	7
Brown clay	26	37	11
Hard blue clay	37	42	5
Brown sand	42	54	12
Fine gray sand	54	143	89
Coarse gray sand, some binder	143	156	13
Coarse sand & small gravel - water bearing	156	187	31
Gray sand with gray clay binder	187	230	43
Sand - some water	230	234	4
Sand & blue clay	234	246	12
Fine gray sand	246	259	13
Blue clay & sand	259	265	6
Heavy blue shale	265	281	16
Blue clay & sand	281	305	24
Fine sand - scattered gravel	305	352	47
Gray sand & clay	352	361	9
Black shale & sand	361	384	23
Brown clay	384	396	12
Sand stone	396	409	13

State Well No. 1N/3-2366
County Mult.
Application No. GR-962

Owner: Reynolds ^{metal} Medals Co Owner's No. #12
Driller: _____ Date Drilled _____

[illegible]