

STATE ENGINEER
Salem, Oregon

MULT Well Record
001327

STATE WELL NO. 1N/3-23G(7)
COUNTY Multnomah
APPLICATION NO. GR-462

OWNER: Reynolds Metals Co.


MAILING ADDRESS: Sundial Rd.

LOCATION OF WELL: Owner's No. 13

CITY AND STATE: Troutdale, Oregon

SW 1/4 NE 1/4 Sec. 23 T. 1 N. R. 3 E. W.M.

Bearing and distance from section or subdivision
corner 2839' N. & 1534' W. from SE cor. sec. 23

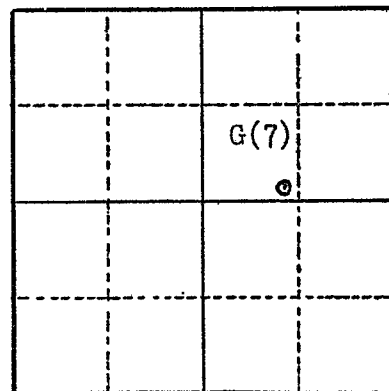

Altitude at well 28.5'

TYPE OF WELL: Drilled Date Constructed 9/9/47

Depth drilled 195' Depth cased 195'

Section 23

CASING RECORD:

20 inch from 0 to 140 feet
12 inch from 127 to 195 feet

FINISH:

AQUIFERS:

WATER LEVEL:
105 feet

PUMPING EQUIPMENT: Type Peerless turbine H.P. 40
Capacity 1200 G.P.M.

WELL TESTS:
Drawdown ft. after hours G.P.M.
Drawdown ft. after hours G.P.M.

USE OF WATER Industrial Temp. °F. 19

SOURCE OF INFORMATION GR-445

DRILLER or DIGGER

ADDITIONAL DATA:

Log X Water Level Measurements Chemical Analysis Aquifer Test

REMARKS:

State Well No. 1M9-236(7)
County Mult.
Application No. GR-462

Owner: Reynolds ^{Metals} ~~Metals~~ Co. Owner's No. #13
Driller: — Date Drilled Sept. 9, '47

[illegible]