

STATE ENGINEER
Salem, Oregon

MULT
001329

Well Record

STATE WELL NO. 1N/3-23H(4)
COUNTY Multnomah
APPLICATION NO. GR-462

OWNER: Reynolds Metals Co.

MAILING
ADDRESS:

Sundial Rd.

LOCATION OF WELL: Owner's No. 7

CITY AND
STATE:

Troutdale, Oregon

SE $\frac{1}{4}$ NE $\frac{1}{4}$ Sec. 23 T. 1 N. 3 E. W.


Bearing and distance from section or subdivision

corner 3404' N. & 947' W. from SE cor., sec. 23

Altitude at well 28.5'

TYPE OF WELL: Drilled Date Constructed 5/12/48

Depth drilled 254' Depth cased 254'

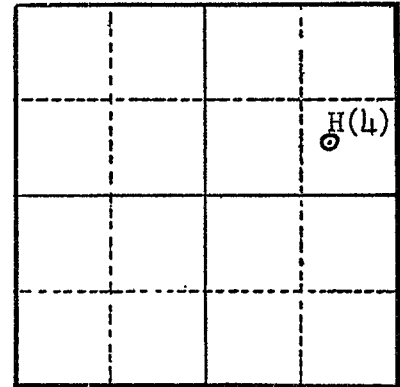

Section 23

CASING RECORD:

18 inch from 0 to 203 feet

12 inch from 190 to 254 feet

FINISH:

AQUIFERS:

WATER LEVEL:
70 feet

PUMPING EQUIPMENT: Type F. M., 5 stage turbine H.P. 60
Capacity 1000 G.P.M.

WELL TESTS:

Drawdown _____ ft. after _____ hours _____ G.P.M.

Drawdown _____ ft. after _____ hours _____ G.P.M.

USE OF WATER Industrial Temp. _____ °F. _____, 19 _____

SOURCE OF INFORMATION GR-445

DRILLER or DIGGER _____

ADDITIONAL DATA:

Log X Water Level Measurements _____ Chemical Analysis _____ Aquifer Test _____

REMARKS:

State Well No. 1N/2-234A
County Mult.
Application No. GR-462

Owner: Reynolds ^{metals} ~~Metals~~ Co. Owner's No. # 7

Driller: _____ Date Drilled May 12, '95[illegible]