

STATE ENGINEER
Salem, Oregon

MULT Well Record

STATE WELL NO. IN/3-23H(5)
COUNTY Multnomah
APPLICATION NO. GR- 462

OWNER: Reynolds Metals Co.

MAILING ADDRESS: Sundial Rd.


LOCATION OF WELL: Owner's No. 8

CITY AND STATE: Troutdale, Oregon

SE $\frac{1}{4}$ NE $\frac{1}{4}$ Sec. 23 T. 1 N. 3 W., W.M.

Bearing and distance from section or subdivision

corner 3581' N. & 804' W. from SE cor. sec. 23

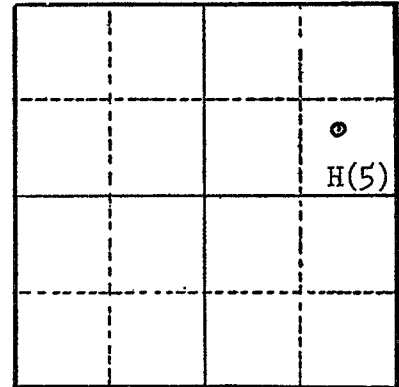

Section 23

Altitude at well 28.5'

TYPE OF WELL: Drilled Date Constructed 9/21/48

Depth drilled 248' Depth cased 248'

CASING RECORD:

18 inch from 0 to 160 feet

12 inch from 152 to 248 feet

FINISH:

AQUIFERS:

WATER LEVEL:
60 feet

PUMPING EQUIPMENT: Type F. M., 5 stage turbine H.P. 60
Capacity 1000 G.P.M.

WELL TESTS:

Drawdown ft. after hours G.P.M.

Drawdown ft. after hours G.P.M.

USE OF WATER Industrial Temp. °F., 19.....

SOURCE OF INFORMATION GR- 445

DRILLER or DIGGER

ADDITIONAL DATA:

Log X Water Level Measurements Chemical Analysis Aquifer Test

REMARKS:

State Well No. 1N/3-23H(5)
County Mult.
Application No. GR-462

Owner: Reynolds Metals Co. Owner's No. # 8
Driller: — Date Drilled Sept. 21, '48

[illegible]