

STATE ENGINEER
Salem, Oregon

MULT Well Record

STATE WELL NO. 1N/3-23H(2)
COUNTY Multnomah
APPLICATION NO. GR- 462

OWNER: Reynolds Metals Co. 1331


MAILING
ADDRESS: Sundial Rd.

LOCATION OF WELL: Owner's No. 5

CITY AND
STATE: Troutdale, Oregon

SE 1/4 NE 1/4 Sec. 23 T. 1 N. R. 3 E. W.M.

Bearing and distance from section or subdivision
corner 3740' N. & 1015' W. from SE cor. sec. 23

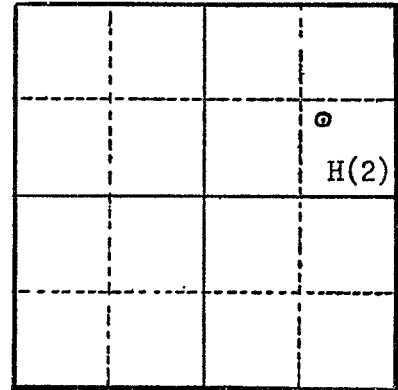

Altitude at well 28.5'

TYPE OF WELL: Drilled Date Constructed Apr. 1943

Depth drilled 330' Depth cased 277'

Section 23

CASING RECORD:
16 inch

FINISH:

AQUIFERS:

WATER LEVEL:
60 feet

PUMPING EQUIPMENT: Type Pamona, 7 stage turbine H.P. 150
Capacity 1500 G.P.M.

WELL TESTS:
Drawdown 20 ft. after 1900 G.P.M.
Drawdown ft. after hours G.P.M.

USE OF WATER Industrial Temp. °F. 19

SOURCE OF INFORMATION GR- 445

DRILLER or DIGGER

ADDITIONAL DATA:

Log X Water Level Measurements Chemical Analysis Aquifer Test

REMARKS:

Salem, Oregon

State Well No. 1N/3-234(2)

County Mult.

Application No. GR-462

Well Log

Owner: Reynolds ^{Metals} ~~Medals~~ Co. Owner's No. # 5

Driller: _____ Date Drilled April '43[illegible]