

STATE ENGINEER
Salem, Oregon

MULT
001341

Well Record

STATE WELL NO. 1N/3-26K
COUNTY Multnomah
APPLICATION NO. GR-4131

OWNER: Glen Elsworth Oakes


MAILING ADDRESS: Route 2, Box 57

LOCATION OF WELL: Owner's No.

CITY AND STATE: Troutdale, Oregon

NW 1/4 SE 1/4 Sec. 26 T. 1 N. S. R. 3 W., W.M.

Bearing and distance from section or subdivision corner N. 45° 30' W. SE Cor. Sec. 26

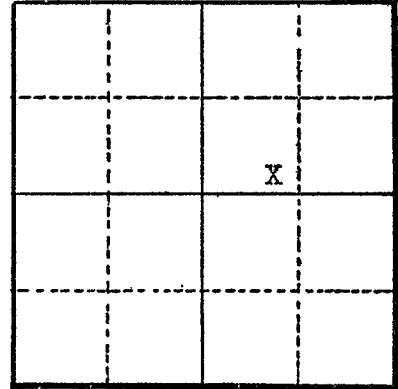

Section 26

Altitude at well

TYPE OF WELL: Drilled Date Constructed 7/7/55

Depth drilled 94 ft. Depth cased 94 ft.

CASING RECORD:

6 inch casing set to 94 ft.

FINISH:

Well casing is a series of standard length threaded and coupled pipe all the way with a regulation drive shoe screwed on the end. No perforations.

AQUIFERS:

WATER LEVEL:

77 1/2 feet below surface

PUMPING EQUIPMENT: Type Myers submersible 1" H.P. 1

Capacity 20 G.P.M.

WELL TESTS:

Drawdown None ft. after hours 20 G.P.M.

Drawdown ft. after hours G.P.M.

USE OF WATER Irrigation Temp. °F. 19

SOURCE OF INFORMATION Well Registration Statement Cert. # GR-3708

DRILLER or DIGGER

ADDITIONAL DATA:

Log X Water Level Measurements Chemical Analysis Aquifer Test

REMARKS: