

STATE ENGINEER
Salem, Oregon

OBSERVATION WELL
MULT Well Record
001342

STATE WELL NO. 1N/3-26R
COUNTY MULTNOMAH
APPLICATION NO. GR-2425

OWNER: Kazuo Fujii


MAILING ADDRESS: Troutdale,

LOCATION OF WELL: Owner's No. _____

CITY AND STATE: Oregon

SE 1/4 SE 1/4 Sec. 26 T. 1 N. S. R. 3 E. W., W.M.

Bearing and distance from section or subdivision corner 750' W. and 800' N.

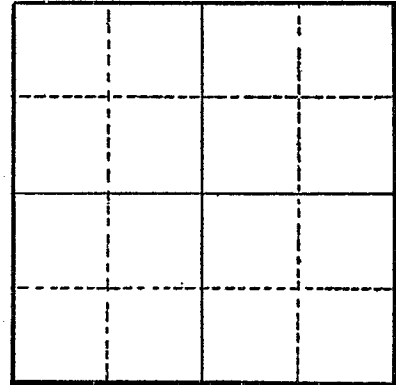

Section _____

Altitude at well _____

TYPE OF WELL: Drilled Date Constructed 1953

Depth drilled 478 Depth cased 350

CASING RECORD:

10-inch

FINISH:

AQUIFERS:

WATER LEVEL:

105-feet

PUMPING EQUIPMENT: Type Turbine Western Landroller H.P. 30
Capacity 300 G.P.M.

WELL TESTS:

Drawdown 65 ft. after _____ hours Pumping 400 G.P.M.

Drawdown _____ ft. after _____ hours _____ G.P.M.

USE OF WATER Irrigation Temp. _____ °F. _____, 19_____

SOURCE OF INFORMATION GR-2303

DRILLER or DIGGER Haakon Bottner, 11544 N.E. Glison St., Portland 16, Oregon

ADDITIONAL DATA:

Log _____ Water Level Measurements _____ Chemical Analysis _____ Aquifer Test _____

REMARKS: