

STATE ENGINEER
Salem, Oregon

MULT
001359

Well Record

STATE WELL NO. LN/3-27F
COUNTY Multnomah
APPLICATION NO. GR-3339

OWNER: William Alan Townsend and
Florence M. Townsend

MAILING ADDRESS: Route 2, Box 111


LOCATION OF WELL: Owner's No.

CITY AND STATE: Troutdale, Oregon

SE 1/4 NW 1/4 Sec. 27 T. 1 N. S. R. 3 E. W.M.

Bearing and distance from section or subdivision

corner 900' N. and 500' W.

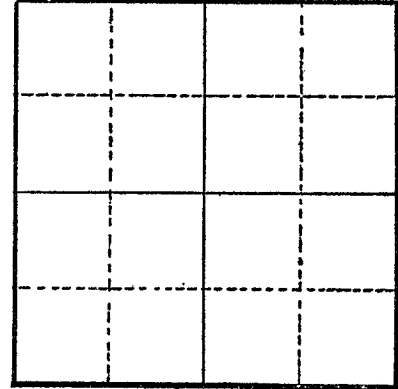

Section

Altitude at well

TYPE OF WELL: drilled Date Constructed 1939

Depth drilled 76' Depth cased 60'

CASING RECORD:

6"

FINISH:

perforations

AQUIFERS:

sandy loam, sand rock, gravel

WATER LEVEL:

25'

PUMPING EQUIPMENT: Type Jacuzzi H.P. 10
Capacity 150 G.P.M.

WELL TESTS:

Drawdown 15 ft. after hours pumping 150 G.P.M.

Drawdown ft. after hours G.P.M.

USE OF WATER Dairy & Irrigation Temp. °F., 19.....

SOURCE OF INFORMATION GR-3093

DRILLER or DIGGER

ADDITIONAL DATA:

Log Water Level Measurements Chemical Analysis Aquifer Test

REMARKS:

Sandy Loam 12
Layer Sand Rock 4 to 6
Gravel Material to bottom 72'