

STATE ENGINEER
Salem, Oregon

MULT
001361

Well Record

GR-1584

STATE WELL NO. 1N/3-27H
COUNTY Multnomah
APPLICATION NO. GR-1438

OWNER: Fairview Farms Inc.


MAILING ADDRESS: Rt. 2, Box 40

LOCATION OF WELL: Owner's No. #1

CITY AND STATE: Troutdale, Oregon

SE 1/4 NE 1/4 Sec. 27 T. 1 N. 35 R. 3 E. W.M.

Bearing and distance from section or subdivision corner For location see sketch on map

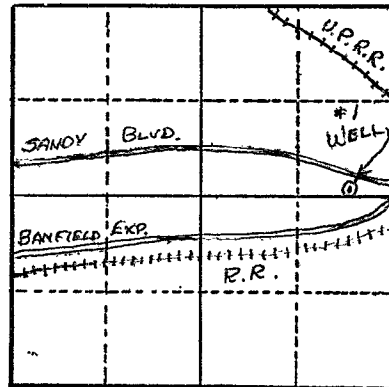

Section 27

Altitude at well 65'

TYPE OF WELL: Drilled Date Constructed 1954

Depth drilled 182' Depth cased 162'

CASING RECORD:
8"

FINISH:

Perforated: from 139' to 143'
from 143' to 150'

AQUIFERS:

WATER LEVEL:

PUMPING EQUIPMENT: Type Peerless turbine H.P. 10
Capacity 100 G.P.M.

WELL TESTS:

Drawdown 85 ft. after 110 hours G.P.M.
Drawdown ft. after hours G.P.M.

USE OF WATER Dom., Irrigation & Manuf. Temp. °F., 19

SOURCE OF INFORMATION GR Record

DRILLER or DIGGER

ADDITIONAL DATA:

Log Water Level Measurements Chemical Analysis Aquifer Test

REMARKS:

Log: Top soil	0 to 6 ft.
Yellow clay	6 to 14 ft.
Yellow clay & boulders	14 to 29 ft.
Blue clay, sand & silt	29 to 137 ft.
Gravel	137 to 150 ft.
Gravel with binder	150 to 160 ft.
Brown clay	160 to 164 ft.
Cemented gravel	164 to 182 ft.

Irrigation of 10 acres