

STATE ENGINEER
Salem, Oregon

MULT
001362

Well Record

GR- 1585

STATE WELL NO. 1N/3-27H
COUNTY Multnomah
APPLICATION NO. GR- 1439

OWNER: Fairview Farms Inc.


MAILING ADDRESS: Rt. 2, Box 40

LOCATION OF WELL: Owner's No. #2

CITY AND STATE: Troutdale, Oregon

SE 1/4 NE 1/4 Sec. 27 T. 1 N. E. R. 3 W., W.M.

Bearing and distance from section or subdivision corner For location see sketch on map

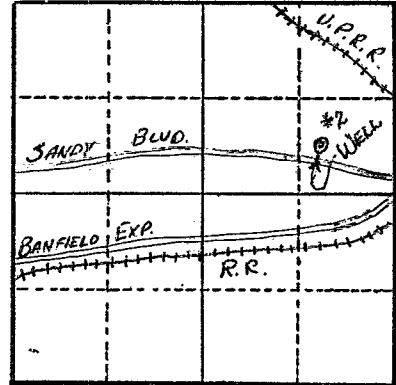

Section 27

Altitude at well 60'

TYPE OF WELL: Drilled Date Constructed 1939

Depth drilled 408' Depth cased 150'

CASING RECORD:

12"

FINISH:

Perforated: from 66 to 75 ft.
from 76 to 83 ft.

AQUIFERS:

WATER LEVEL:

30'

PUMPING EQUIPMENT: Type Pomona turbine H.P. 20
Capacity 200 G.P.M.

WELL TESTS:

Drawdown 35 ft. after 800 hours G.P.M.
Drawdown ft. after hours G.P.M.

USE OF WATER Dom. Irrigation & Manuf. Temp. °F., 19

SOURCE OF INFORMATION GR Record

DRILLER or DIGGER

ADDITIONAL DATA:

Log Water Level Measurements Chemical Analysis Aquifer Test

REMARKS:

First 166 ft. unknown

Log: Cemented gravel	167 to 274 ft.
Yellow clay	274 to 278 ft.
Dark binder in gravel	278 to 324 ft.
Green sand stone	324 to 346 ft.
Gray sand stone	346 to 392 ft.
Cemented gravel	392 to 408 ft.

Irrigation of 2 acres.

