STATE ENGINEER
Salem, Oregon

MULT
001363

Well Record

STATE WELL NO. 1N/3-27M1
COUNTY MULTNOMAH
APPLICATION NO. .....

OWNER: City of Fairview

MAILING ADDRESS: .....

CITY AND STATE: .....

LOCATION OF WELL: Owner's No. .....

.....¼ .....¼ Sec. ..... T. ..... N. S., R. ..... E. W., W.M.

Bearing and distance from section or subdivision corner .....

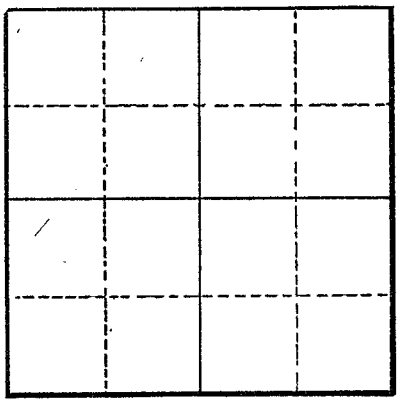

Section .....

Altitude at well 130

TYPE OF WELL: Drilled Date Constructed .....

Depth drilled 1,060 Depth cased 830

CASING RECORD:

12 inch

FINISH:

AQUIFERS: Gravel, Troutdale Formation, from 265 to 345
Sandstone from 967 to 975

WATER LEVEL:
92.7 feet below land surface on July 30, 1958

PUMPING EQUIPMENT: Type ..... H.P. .....
Capacity ..... G.P.M.

WELL TESTS:
Drawdown ..... ft. after ..... hours ..... G.P.M.
Drawdown ..... ft. after ..... hours ..... G.P.M.

USE OF WATER Public Supply Temp. ..... °F. ....., 19.....
SOURCE OF INFORMATION USGS
DRILLER or DIGGER .....
ADDITIONAL DATA:
Log X Water Level Measurements ..... Chemical Analysis ..... Aquifer Test .....

REMARKS:

Pumped 400 gpm.
Perforated 320-340 feet.

State Printing 89316

STATE ENGINEER
Salem, Oregon

State Well No. 1N/3-27M1
County MULTNOMAH
Application No.

Well Log

Owner: City of Fairview Owner's No.

Driller: Barron & Strayer Date Drilled 1956

CHARACTER OF MATERIAL	(Feet below land surface) From	To	Thickness (feet)
Troutdale Formation:			
Clay	0	5	5
Boulders and gravel	5	20	15
Gravel	20	59	39
Gravel, cemented	59	83	24
Clay, blue	83	105	22
Silt	105	125	20
Gravel, sandy, water-bearing	125	140	15
Gravel, cemented; bottom of 12-in. casing at 182 feet.	140	203	63
Silt	203	265	62
Gravel, clean	265	320	55
Gravel, muddy	320	345	25
Gravel, cemented, static water level 110 ft.	345	360	15
Sandy River Mudstone (?):			
Clay, yellow, sandy	360	380	20
Sand, fine, "heaving"	380	420	40
"Rock" (gravel?), coarse	420	445	25
Silt, sandy	445	495	50
Sand, heaving	495	535	40
Shale, blue	535	540	5
Sand, black	540	560	20
Sand, some gravel	560	575	15
Sand, fine, white; static water level dropped			

(Continued)

Continued--

STATE ENGINEER
Salem, Oregon

State Well No. 1N/3-22M1
County
Application No.

Well Log

Owner: City of Fairview Owner's No.

Driller: Date Drilled

CHARACTER OF MATERIAL	(Feet below land surface) From	To	Thickness (feet)
to 120 ft. at 585-ft. depth	575	625	50
Gravel, water-bearing	625	626	1
Sand, fine, white	626	670	44
Sand, fine, and gravel	670	690	20
Sandstone, hard, "sharp"	690	705	15
Shale, blue	705	715	10
Sand, fine	715	735	20
Gravel, small, sandy, caving	735	745	10
Clay, gray, sandy	745	755	10
Clay, yellow; bottom of 10-in. casing at 800-ft. depth	755	800	45
Columbia River Basalt:			
Rock, gray, hard; open 10-in. hole below 800-ft. depth	800	810	10
Rock, broken	810	826	16
Clay	826	827	1
Rock, black, hard	827	850	23
Rock, hard, some blue clay	850	875	25
Rock, black	875	900	25
Clay, blue	900	915	15
Rock, gray	915	920	5
Older rocks:			
Clay, blue; static water level 90 ft.	920	935	15
"Shell," hard	935	937	2

Continued--

STATE ENGINEER
Salem, Oregon

State Well No. 1N/3-27M1
County .....
Application No. .....

Well Log

Owner: City of Fairview Owner's No. .....

Driller: ..... Date Drilled .....

CHARACTER OF MATERIAL	(Feet below land surface) From	To	Thickness (feet)
Clay	937	950	13
"Sand rock," (tuffaceous (?) sandstone), hard, gray	950	965	15
Clay, blue	965	967	2
Sandstone, gray, hard, water-bearing	967	975	8
Rock, hard, black	975	998	23
Clay, red and pink	998	1,002	4
Rock, broken, hard, drilled muddy	1,002	1,030	28
Rock, broken, and blue clay	1,030	1,045	15
Sand, gray, and clay	1,045	1,060	15