

STATE ENGINEER
Salem, Oregon

MULT Well Record

STATE WELL NO. IN/3-26K
COUNTY MULTNOMAH
APPLICATION NO. GR-2955

001365

OWNER: JAMES G. SIMONI

MAILING ADDRESS:

P.O. Box 42

LOCATION OF WELL: Owner's No. _____


CITY AND STATE:

Trautdale, Oregon

NW $\frac{1}{4}$ SE $\frac{1}{4}$ Sec. 26 T. 1 S, R. 3 W, W.M.

Bearing and distance from section or subdivision

corner N. 37° 30' W.

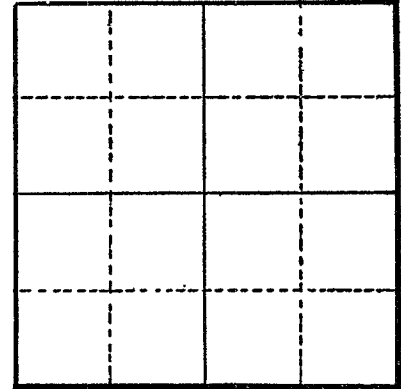

Section _____

Altitude at well _____

TYPE OF WELL: drilled Date Constructed 1945

Depth drilled 50 Depth cased 50

CASING RECORD:

8-inch

FINISH:

AQUIFERS:

WATER LEVEL:

10-feet

PUMPING EQUIPMENT: Type Pacific Pump Co., Model 1 1/2 L. H.P. 3

Capacity 45 G.P.M.

WELL TESTS:

Drawdown _____ ft. after _____ hours _____ G.P.M.

Drawdown _____ ft. after _____ hours _____ G.P.M.

USE OF WATER Irrigation Temp. _____ °F. _____, 19____

SOURCE OF INFORMATION GR-2773

DRILLER or DIGGER _____

ADDITIONAL DATA:

Log _____ Water Level Measurements _____ Chemical Analysis _____ Aquifer Test _____

REMARKS: