


STATE ENGINEER
Salem, Oregon

MULT Well Record
001383

STATE WELL NO. 1N/3-28E
COUNTY Multnomah
APPLICATION NO. GR-2757

OWNER: Merrill D. and Melba S. Femrite
Femrite's Nursery
MAILING ADDRESS: Route 2, Box 355
CITY AND STATE: Troutdale, Oregon

LOCATION OF WELL: Owner's No.
SW 1/4 NW 1/4 Sec. 28 T. 1 N. R. 3 E. W.M.
Bearing and distance from section or subdivision
corner 1160 feet North and 1225 feet East from
W/4 Corner, Section 28.

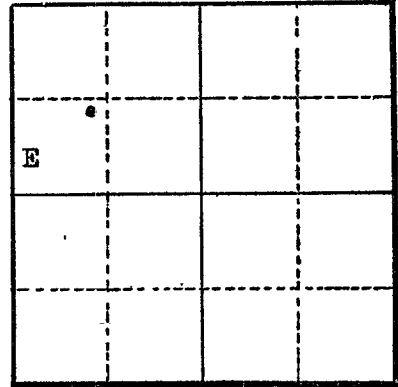

Section 28

Altitude at well

TYPE OF WELL: drilled Date Constructed unknown

Depth drilled Doubtful Depth cased 50 feet

CASING RECORD:

6-inch casing set to 50 feet

FINISH:

AQUIFERS:

WATER LEVEL:

50 feet

PUMPING EQUIPMENT: Type Centrifical H.P.

Capacity 125 G.P.M.

WELL TESTS:

Drawdown 10 ft. after 50 hours G.P.M.

Drawdown ft. after hours G.P.M.

USE OF WATER Irrigation Temp. °F., 19

SOURCE OF INFORMATION GR-4012

DRILLER or DIGGER P. Olson

ADDITIONAL DATA:

Log (NA) Water Level Measurements Chemical Analysis Aquifer Test

REMARKS: