

STATE ENGINEER
Salem, Oregon

MULT Well Record
001386

STATE WELL NO. 1N/3-28Q(1)
COUNTY Multnomah
APPLICATION NO. GR-365

OWNER: City of Fairview


MAILING ADDRESS:

LOCATION OF WELL: Owner's No.

CITY AND STATE: Fairview, Oregon

SW 1/4 SE 1/4 Sec. 28 T. 1 N. 3 E. W.M.

Bearing and distance from section or subdivision corner 1640' W. & 250' N. of SE cor. of sec. 28

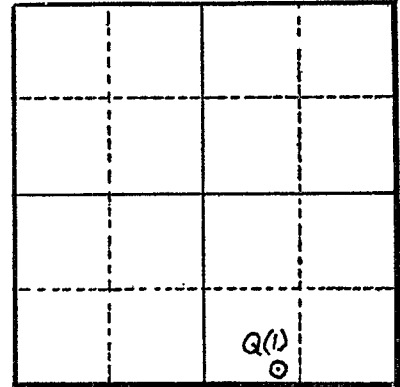

Section 28

Altitude at well 175'

TYPE OF WELL: Drilled Date Constructed June '39

Depth drilled 140' Depth cased

CASING RECORD:

10 inch

FINISH:

AQUIFERS:

WATER LEVEL:

60 feet

PUMPING EQUIPMENT: Type Deming "A" turbine H.P. 10

Capacity 190 G.P.M.

WELL TESTS:

Drawdown ft. after hours G.P.M.

Drawdown ft. after hours G.P.M.

USE OF WATER Municipal Temp. °F. 19

SOURCE OF INFORMATION GR-349

DRILLER or DIGGER A. C. Zesing

ADDITIONAL DATA:

Log NA Water Level Measurements Chemical Analysis Aquifer Test

REMARKS: