

STATE ENGINEER
Salem, Oregon

MULT
001403

Well Record

STATE WELL NO. 1N/3-29E
COUNTY Multnomah
APPLICATION NO. GR-3016

OWNER: Daniel P. and Jane E. Schmidt


MAILING ADDRESS: Route 2, Box 390

LOCATION OF WELL: Owner's No. _____

CITY AND STATE: Troutdale, Oregon

SW $\frac{1}{4}$ NW $\frac{1}{4}$ Sec. 29 T. 1 N. S., R. 3 E. W., W.M.

Bearing and distance from section or subdivision corner S. 31° W., N.W. cor. Sec. 29

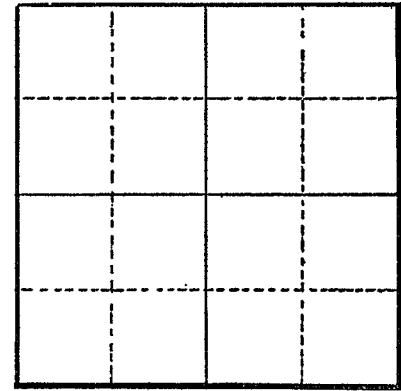

Section _____

Altitude at well _____

TYPE OF WELL: drilled Date Constructed 1951

Depth drilled 198 Depth cased 198 feet

CASING RECORD:

8 inches

FINISH:

AQUIFERS:

WATER LEVEL:
60 feet

PUMPING EQUIPMENT: Type Fairbanks - Morse H.P. 15
Capacity 150 G.P.M.

WELL TESTS:
Drawdown 15 ft. after _____ hours Pumping 150 G.P.M.
Drawdown _____ ft. after _____ hours _____ G.P.M.

USE OF WATER Irrigation Temp. _____ °F., 19 _____

SOURCE OF INFORMATION GR-2823

DRILLER or DIGGER Bottner, 11544, N.E. Glison, Portland, Oregon

ADDITIONAL DATA:
Log _____ Water Level Measurements _____ Chemical Analysis _____ Aquifer Test _____

REMARKS: