

STATE ENGINEER
Salem, Oregon

MULT Well Record
001404

STATE WELL NO. 1N/3-29 H
COUNTY Multnomah
APPLICATION NO. GR-4268

OWNER: F. D. Shepard


MAILING ADDRESS: 3150 NE 126th Place

LOCATION OF WELL: Owner's No.

CITY AND STATE: Portland, Oregon

SE 1/4 NE 1/4 Sec. 29 T. 1 N. 3 R. 3 W., W.M.

Bearing and distance from section or subdivision corner from center of 201st Street and Sandy Road 453 feet South; thence 222 feet West

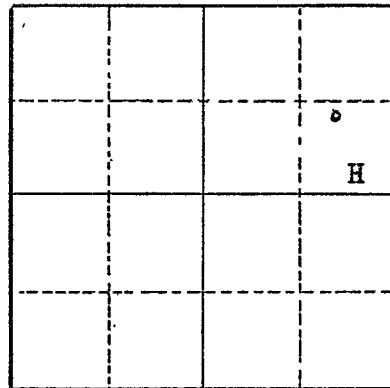

Altitude at well 250 feet

TYPE OF WELL: Drilled Date Constructed Oct. 1, 1951

Depth drilled 250 feet Depth cased 253 feet

Section 29

CASING RECORD:

8-inch casing set from 0 to 159 feet
6-inch casing set from 159 to 253 feet

FINISH:

AQUIFERS:

clay, gravel, and sandstone

WATER LEVEL:

55 feet

PUMPING EQUIPMENT: Type US Motor Jacuzzi Pump 20 HP

H.P.

Capacity 400 G.P.M.

WELL TESTS:

Drawdown 0 / in 24 hours ft. after 350 hours G.P.M.

Drawdown ft. after hours G.P.M.

USE OF WATER Domestic, Irrigation Temp. °F., 19

SOURCE OF INFORMATION GR-4119

DRILLER or DIGGER

ADDITIONAL DATA:

Log Water Level Measurements Chemical Analysis Aquifer Test

REMARKS:

clay 0 to 10 cemented gravel 120 to 125
sandstone 10 to 15 sand & gravel 125 to 175
boulders 15 to 58 sandstone 125 to 175
cemented gravel 58 to 114 cemented gravel 184 to 230
gravel 114 to 120 water bearing gravel 230 to 250

Static water level 55 feet below surface. Recommended pumping level 140 feet at 350 gallons per minute.