

STATE ENGINEER
Salem, Oregon

MULT
001405

Well Record

STATE WELL NO. 1N/3-290
COUNTY Multnomah
APPLICATION NO. GR-1693

GR-1643

OWNER: J. Frank Schmidt, Jr.


MAILING ADDRESS: 19343 NE Halsey St.

LOCATION OF WELL: Owner's No.

CITY AND STATE: Troutdale, Oregon

SW 1/4 SE 1/4 Sec. 29 T. 1 N. R. 3 E. W.M.

Bearing and distance from section or subdivision corner 1700' W. & 570' N. from SE cor. Sec. 29

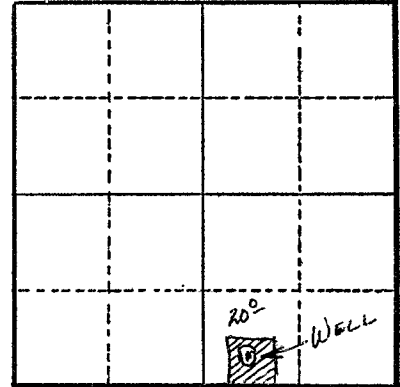

Section 29

Altitude at well 140'

TYPE OF WELL: Drilled Date Constructed 1946

Depth drilled 142.25' Depth cased 142.25'

CASING RECORD:

8"

FINISH:

Perforated: 65 to 80 ft.
85 to 100 ft.
104 to 120 ft. 123 to 137 ft.

AQUIFERS:

WATER LEVEL:

55'

PUMPING EQUIPMENT: Type A. D. Cook turbine H.P. 10

Capacity 125 G.P.M.

WELL TESTS:

Drawdown 90 ft. after 120 hours G.P.M.

Drawdown ft. after hours G.P.M.

USE OF WATER Irrigation Temp. °F. 19

SOURCE OF INFORMATION GR Record

DRILLER or DIGGER Zehrung & Son

ADDITIONAL DATA:

Log N. A. Water Level Measurements Chemical Analysis Aquifer Test

REMARKS:

Irrigation of 20 acres.