

STATE ENGINEER  
Salem, Oregon

# Well Record

STATE WELL NO. 1N/3 - 30D  
COUNTY MULTNOMAH  
APPLICATION NO. GR-2228

MULT  
001411

OWNER: Paul and Frances Montecucco


MAILING ADDRESS: 3600N. E. 162nd. Ave.

LOCATION OF WELL: Owner's No. \_\_\_\_\_

CITY AND STATE: Portland, Oregon

NW  $\frac{1}{4}$  NW  $\frac{1}{4}$  Sec. 30 T. 1 N. S., R. 3 E. W., W.M.

Bearing and distance from section or subdivision corner 278' S. and 69' E.

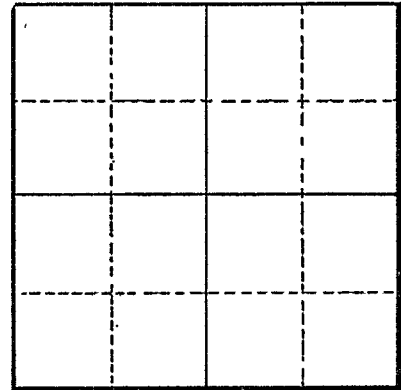

Section \_\_\_\_\_

Altitude at well \_\_\_\_\_

TYPE OF WELL: Drilled Date Constructed 1952

Depth drilled 495 Depth cased 96 420

### CASING RECORD:

8-Inch  
6-Inch

### FINISH:

Perforations from 112 to 200  
Perforations from 407 to 417

### AQUIFERS:

Gravel and clay

### WATER LEVEL:

60-Feet

PUMPING EQUIPMENT: Type Pacific Turbine H.P. 5  
Capacity 80 G.P.M.

### WELL TESTS:

Drawdown 14 ft. after \_\_\_\_\_ hours Pumping 150 G.P.M.  
Drawdown \_\_\_\_\_ ft. after \_\_\_\_\_ hours \_\_\_\_\_ G.P.M.

USE OF WATER Irrigation Temp. \_\_\_\_\_ °F. \_\_\_\_\_, 19\_\_\_\_

SOURCE OF INFORMATION GR-2134

DRILLER or DIGGER \_\_\_\_\_

### ADDITIONAL DATA:

Log  Water Level Measurements \_\_\_\_\_ Chemical Analysis \_\_\_\_\_ Aquifer Test \_\_\_\_\_

### REMARKS:

STATE ENGINEER  
Salem, Oregon

State Well No. 1N/3 - 30D  
County MULTNOMAH  
Application No. GR 2228

## Well Log

Owner: Paul and Frances Montecucco Owner's No. \_\_\_\_\_

Driller: \_\_\_\_\_ Date Drilled \_\_\_\_\_

CHARACTER OF MATERIAL	(Feet below land surface)		Thickness (feet)
	From	To	
Formation			
Top soil	Surface	6	
Loose gravel	6	21	
Cemented gravel	21	50	
Loose gravel	50	55	
Cemented gravel	55	200	
Dark rock	200	213	
Blue clay	213	235	
Green clay	235	241	
Solid cemented gravel	241	244	
Grey clay	244	259	
Brown clay	259	280	
Blue clay	280	310	
Grey clay	310	325	
Light blue clay	325	355	
Cemented gravel	355	406	
Gravel, some sand, water bearing	406	422	
Blue clay	422	450	
Yellow clay	450	453	
Blue clay	453	461	
Light blue clay	461	495	

✓