

STATE ENGINEER
Salem, Oregon

MULT
001412

Well Record

STATE WELL NO. 1N/3-30H
COUNTY Multnomah
APPLICATION NO. GR-1403

GR- 1358

OWNER: Mr. & Mrs. Alfred G. Aplan

MAILING ADDRESS:

5543 NE Killingsworth


LOCATION OF WELL: Owner's No.

CITY AND STATE:

13
Portland, Oregon

SE 1/4 NE 1/4 Sec. 30 T. 1 N. R. 3 E. W.M.

Bearing and distance from section or subdivision
corner 308' S. & 220' W. from SE cor. R.P. Wilmor DIC.

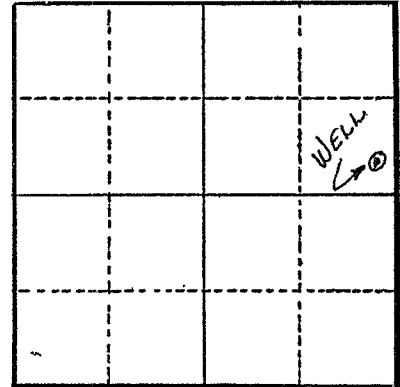

Section 30

Altitude at well 40 ft.

TYPE OF WELL: Drilled Date Constructed 1954

Depth drilled 390 ft. Depth cased 357 ft.

CASING RECORD:

10 in. standard black steel pipe from 0 to 123 ft.
8 in. " " " " 0 to 357 ft.

FINISH:

AQUIFERS:

WATER LEVEL:

110 ft.

PUMPING EQUIPMENT: Type Johnston turbine 8 in. H.P. 30
Capacity 300 G.P.M.

WELL TESTS:

Drawdown 40 ft. after _____ hours 300 G.P.M.
Drawdown 62 ft. after _____ hours 530 G.P.M.

USE OF WATER Irrigation Temp. _____ °F., 19

SOURCE OF INFORMATION G. R. Record

DRILLER or DIGGER Haaken I. Bottner

ADDITIONAL DATA:

Log Water Level Measurements _____ Chemical Analysis _____ Aquifer Test _____

REMARKS:

Irrigation of 32 acres.

