

STATE ENGINEER
Salem, Oregon

Well Record

STATE WELL NO. 1N/3-34A
COUNTY Multnomah
APPLICATION NO. GR-1589

MULT
001426

GR- 1537

OWNER: City of Wood Village


MAILING ADDRESS: Wood Village City Hall

LOCATION OF WELL: Owner's No. _____

CITY AND STATE: Troutdale, Oregon

NE 1/4 NE 1/4 Sec. 34 T. 1 N. R. 3 E.
~~SE~~ W.M.

Bearing and distance from section or subdivision
corner 1225' W. & 580' S. from NE cor. Sec. 24

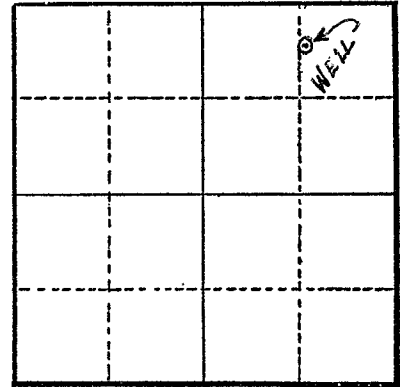

Section 34

Altitude at well 168'

TYPE OF WELL: Drilled Date Constructed 1942

Depth drilled 360' Depth cased 355'

CASING RECORD:

- 10" from 0 to 170 ft.
- 8" from 170 to 355 ft.

FINISH:

- Perforated from: 170 to 180 ft.
- 284 to 294 ft.
- 340 to 355 ft.

AQUIFERS:

WATER LEVEL:

65'

PUMPING EQUIPMENT: Type Pomona deep well turbine H.P. 20
Capacity 200 G.P.M.

WELL TESTS:

Drawdown 100 ft. after _____ hours 200 G.P.M.
 Drawdown _____ ft. after _____ hours _____ G.P.M.

USE OF WATER Municipal Temp. _____ °F., 19 _____

SOURCE OF INFORMATION GR Record

DRILLER or DIGGER R. J. Strasser

ADDITIONAL DATA:

Log _____ Water Level Measurements _____ Chemical Analysis _____ Aquifer Test _____

REMARKS:

- Log: Top soil 0 to 15 ft.
- Gravel & boulders 15 to 40 ft.
- Boulders 40 to 83 ft.
- Cemented gravel 83 to 103 ft.
- Cemented gravel 103 to 290 ft.
- Loose gravel 290 to 294 ft.
- Sandstone 294 to 330 ft.
- Gray sandstone 330 to 350 ft.
- Sandstone 350 to 360 ft.