

STATE ENGINEER  
Salem, Oregon

MULT Well Record  
001436


STATE WELL NO. 1N/3-35M  
COUNTY Multnomah  
APPLICATION NO. GR-3980

OWNER: Jack C. Barr MAILING ADDRESS: Route 2, Box 770

CITY AND STATE: Troutdale, Oregon

LOCATION OF WELL: Owner's No. NW 1/4 SW 1/4 Sec. 35 T. 1 N. 3, R. 3 E. W.M.

Bearing and distance from section or subdivision corner S. 22°45' E. from W 1/4 Cor. Sec. 35

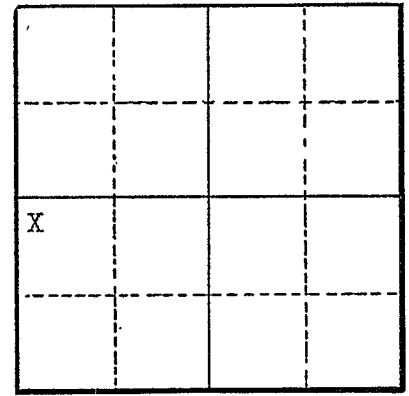

Altitude at well

TYPE OF WELL: Drilled Date Constructed July, 1949

Depth drilled 112 ft. Depth cased 112 ft.

Section 35

CASING RECORD:

6 inch steel casing set to 112 feet

FINISH:

AQUIFERS:

WATER LEVEL:

73 feet below surface

PUMPING EQUIPMENT: Type Jacuzzi (Berkeley) jet H.P. 1  
Capacity 15 G.P.M.

WELL TESTS:

Drawdown ft. after hours G.P.M.  
Drawdown ft. after hours G.P.M.

USE OF WATER Irrigation Temp. °F. 19

SOURCE OF INFORMATION Well Registration Statement Cert. # GR-3594

DRILLER or DIGGER O. B. Olsen

ADDITIONAL DATA:

Log Water Level Measurements Chemical Analysis Aquifer Test

REMARKS: