

STATE ENGINEER
Salem, Oregon

MULT

Well Record

STATE WELL NO. 1N/3-35P(1)
COUNTY Multnomah
APPLICATION NO. GR- 2117

001437

OWNER: Eldon Snider


MAILING ADDRESS: Rt. 2 Box 933

LOCATION OF WELL: Owner's No. 3

CITY AND STATE: Troutdale, Oregon

SE 1/4 SW 1/4 Sec. 35 T. 1 N. R. 3 E. W.M.

Bearing and distance from section or subdivision
corner 2400' E. & 50' N. of SW cor. of sec. 35

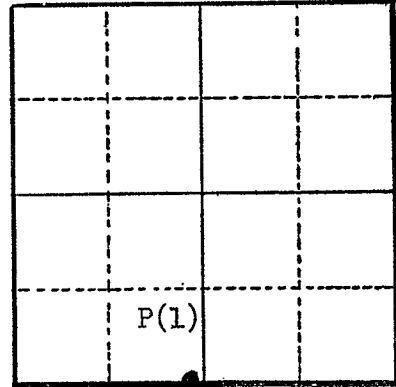

Altitude at well 322'

TYPE OF WELL: Drilled Date Constructed Spring 1946

Depth drilled 90' Depth cased

Section 35

CASING RECORD:
6 inch

FINISH:

Mills knife - 3/8"x1 1/4" (18/ft.) from 67 to 74 feet

AQUIFERS:

Sand & gravel

WATER LEVEL:

PUMPING EQUIPMENT: Type Peerless hylift H.P. 3
Capacity 50 G.P.M.

WELL TESTS:

Drawdown ft. after hours G.P.M.
Drawdown ft. after hours G.P.M.

USE OF WATER Industrial Temp. °F. 19

SOURCE OF INFORMATION GR- 2035

DRILLER or DIGGER

ADDITIONAL DATA:

Log NA Water Level Measurements Chemical Analysis Aquifer Test

REMARKS: