

STATE ENGINEER
Salem, Oregon

MULT
001433

Well Record

STATE WELL NO. 1N/3-35P(2)
COUNTY Multnomah
APPLICATION NO. GR- 2118

OWNER: Eldon Snider


MAILING ADDRESS: Rt. 2 Box 933

LOCATION OF WELL: Owner's No. 1

CITY AND STATE: Troutdale, Oregon

SE 1/4 SW 1/4 Sec. 35 T. 1 N. R. 3 E. W.M.

Bearing and distance from section or subdivision
corner 2320' W. & 200' N. of SW cor. of sec. 35

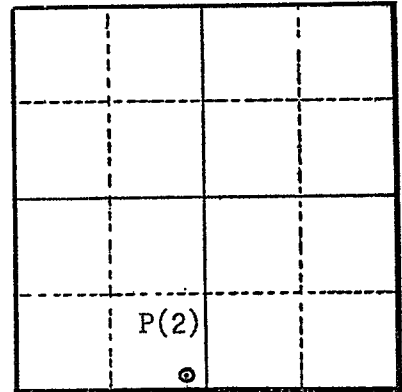

Section 35

Altitude at well 322'

TYPE OF WELL: Drilled Date Constructed 4/26/50

Depth drilled 135' Depth cased 135'

CASING RECORD:

10 inch

FINISH:

Perforated from 58 to 70
108 to 112
114 to 120

AQUIFERS:

Sand & gravel

WATER LEVEL:

48 feet

PUMPING EQUIPMENT: Type Westinghouse, Peerless turbine H.P. 15

Capacity 200 G.P.M.

WELL TESTS:

Drawdown 6 ft. after hours 150 G.P.M.

Drawdown 8 ft. after hours 180 G.P.M.

USE OF WATER Irrigation & Industrial Temp. °F. 19

SOURCE OF INFORMATION GR- 2036

DRILLER or DIGGER R. J. Strasser, Portland

ADDITIONAL DATA:

Log X Water Level Measurements Chemical Analysis Aquifer Test

REMARKS:

