

STATE ENGINEER  
Salem, Oregon

MULT  
001439

# Well Record

STATE WELL NO. 1N/3-35R  
COUNTY Multnomah  
APPLICATION NO. GR-3920

OWNER: Carmen M. Fernandez


MAILING ADDRESS: Route 2, Box 876

LOCATION OF WELL: Owner's No. \_\_\_\_\_

CITY AND STATE: Troutdale, Oregon

SE 1/4 SE 1/4 Sec. 35 T. 1 N. S, R. 3 E. W., W.M.

Bearing and distance from section or subdivision  
corner N. 70°00' W. SE Cor. Sec. 35

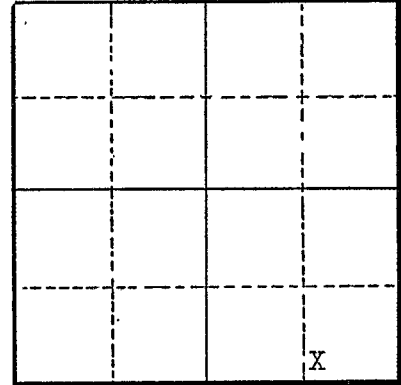

Section 35

Altitude at well \_\_\_\_\_

TYPE OF WELL: Drilled Date Constructed Spring 1977

Depth drilled 100 ft. Depth cased 100 ft.

### CASING RECORD:

6 inch steel casing set to 100 ft.

### FINISH:

has perforations

### AQUIFERS:

### WATER LEVEL:

35 feet below surface

PUMPING EQUIPMENT: Type Jacuzzi turbine H.P. 1  
Capacity 15 G.P.M.

### WELL TESTS:

Drawdown \_\_\_\_\_ ft. after \_\_\_\_\_ hours \_\_\_\_\_ G.P.M.  
Drawdown \_\_\_\_\_ ft. after \_\_\_\_\_ hours \_\_\_\_\_ G.P.M.

USE OF WATER Irrigation Temp. \_\_\_\_\_ °F. \_\_\_\_\_, 19\_\_\_\_\_

SOURCE OF INFORMATION Well Registration Statement Cert. # GR-3557

DRILLER or DIGGER \_\_\_\_\_ Price \_\_\_\_\_

### ADDITIONAL DATA:

Log \_\_\_\_\_ Water Level Measurements \_\_\_\_\_ Chemical Analysis \_\_\_\_\_ Aquifer Test \_\_\_\_\_

### REMARKS: