


WATER SUPPLY WELL REPORT - Map with location identified must be attached and shall include an approximate scale and north arrow

MULT 143922


10/14/2025

Map of Hole

INJECTION WELL IW-01 PRELIMINARY AS-BUILT

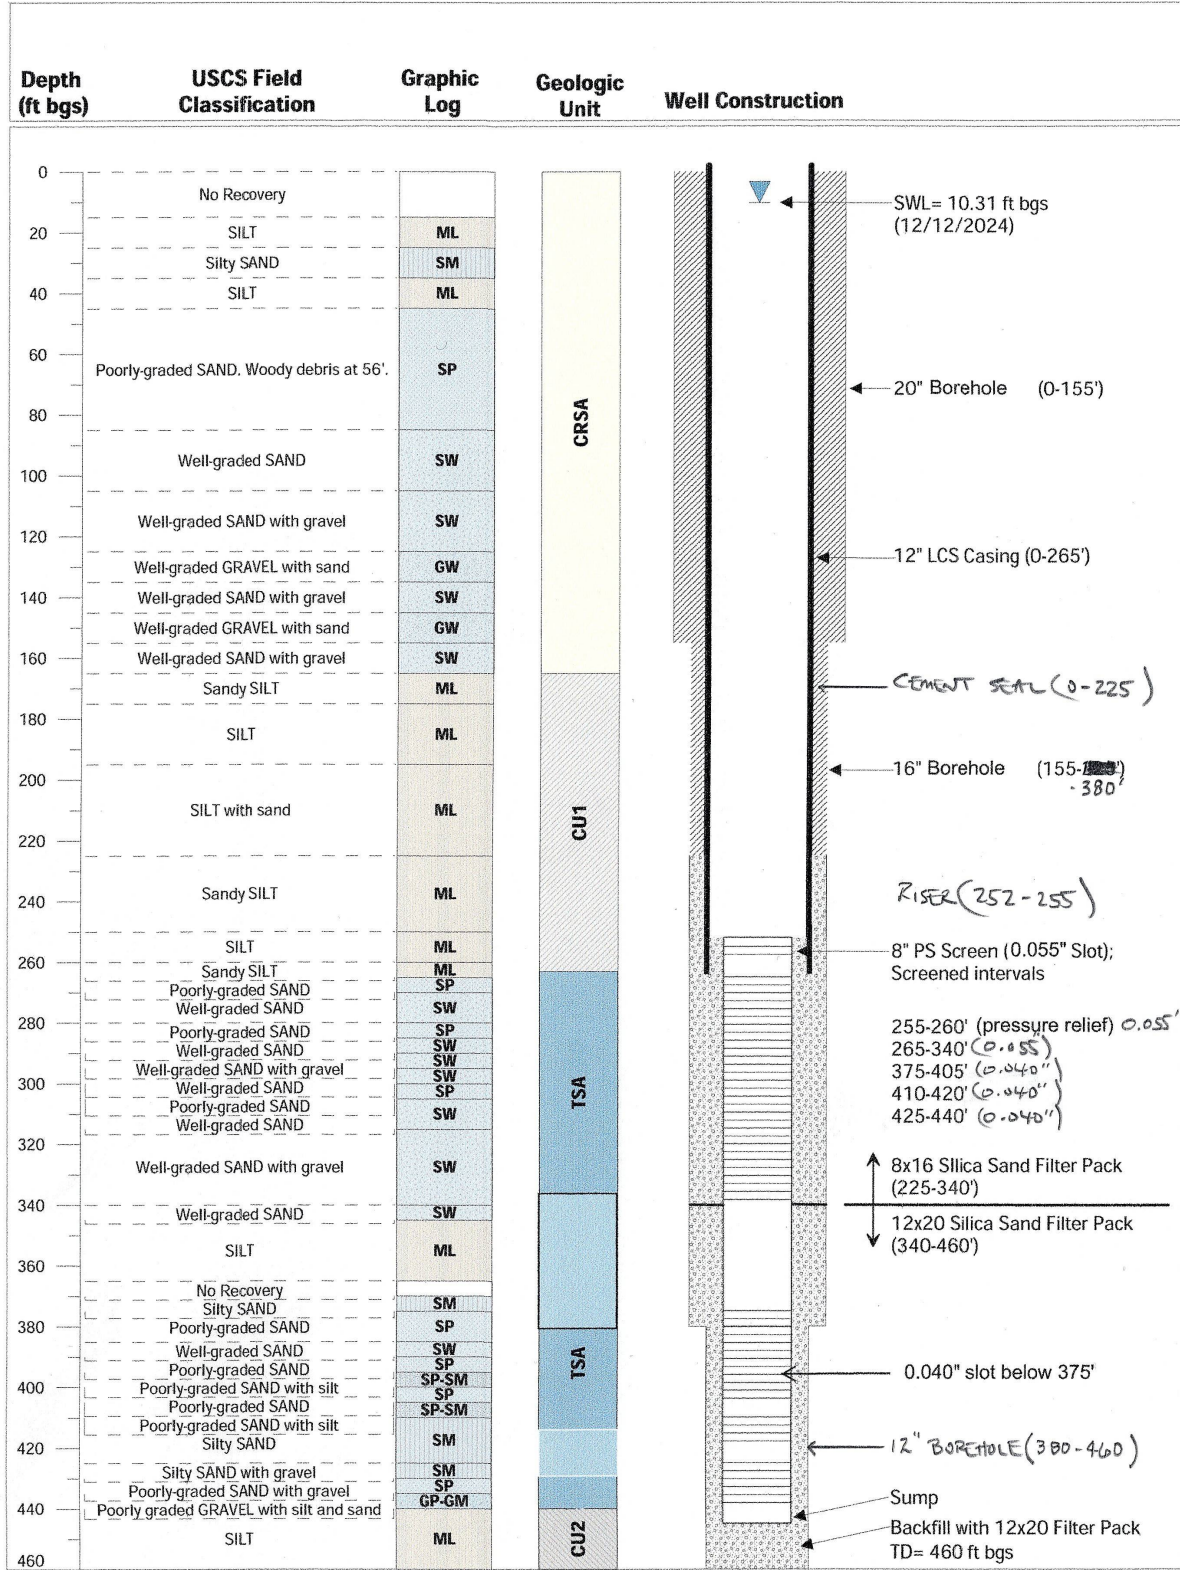

Map of Hole

| | | |
|--|---|---|
| <p>STATE OF OREGON WELL LOCATION MAP</p> | <p>Oregon Water Resources Department 725 Summer St NE, Salem OR 97301 (503)986-0900</p> |  |
| <p>This map is supplemental to the WATER SUPPLY WELL REPORT</p> | | |
| <p>LOCATION OF WELL</p> | <p>Well Label: 136259</p> | |
| <p>Latitude: 45.58375000 Datum: WGS84</p> | <p>Printed: October 14, 2025</p> | |
| <p>Longitude: -122.57820000</p> | <p><small>DISCLAIMER: This map is intended to represent the approximate location the well. It is not intended to be construed as survey accurate in any manner.</small></p> | |
| <p>Township/Range/Section/Quarter-Quarter Section: WM1.00N2.00E9NWSW</p> | <p><small>Provided by well constructor</small></p> | |
| <p>Address of Well: 8171 NE AIRPORT WAY FRONTAGE RD</p> | | |

