






WATER SUPPLY WELL REPORT - Map with location identified must be attached and shall include an approximate scale and north arrow

MULT 143922

10/14/2025

## Map of Hole

### INJECTION WELL IW-01 PRELIMINARY AS-BUILT

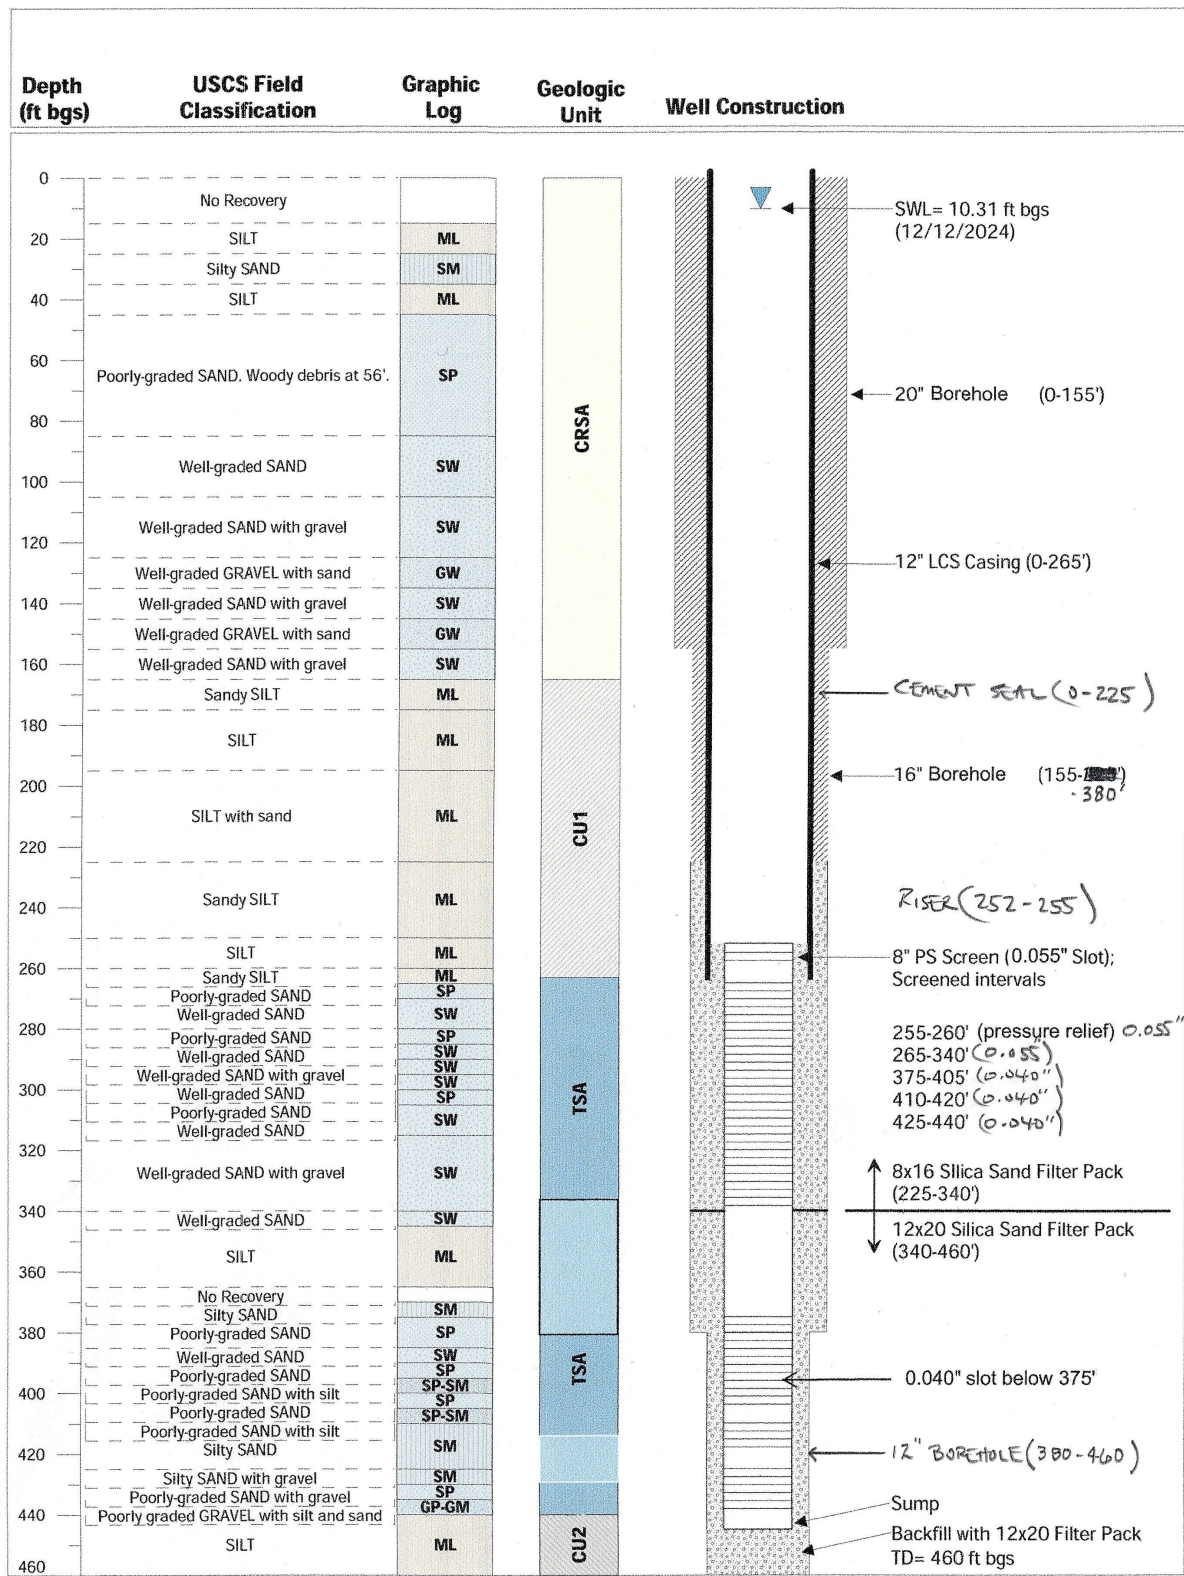



10/14/2025

## Map of Hole

STATE OF OREGON  
WELL LOCATION MAP

This map is supplemental to the WATER SUPPLY WELL REPORT

## Oregon Water Resources Department

725 Summer St NE, Salem OR 97301  
(503)986-0900

## LOCATION OF WELL

Latitude: 45.58375000 Datum: WGS84

Longitude: -122.57820000

Township/Range/Section/Quarter-Quarter Section:

WM1.00N2.00E9NWSW

Address of Well:

8171 NE AIRPORT WAY FRONTAGE RD

Well Label: 136259

Printed: October 14, 2025

DISCLAIMER: This map is intended to represent the approximate location the well. It is not intended to be construed as survey accurate in any manner.

Provided by well constructor

