


New exempt use wells must be submitted with a map and recording fee.

WATER SUPPLY WELL REPORT - Map with location identified must be attached and shall include an approximate scale and north arrow

MULT 143925

10/14/2025

Map of Hole

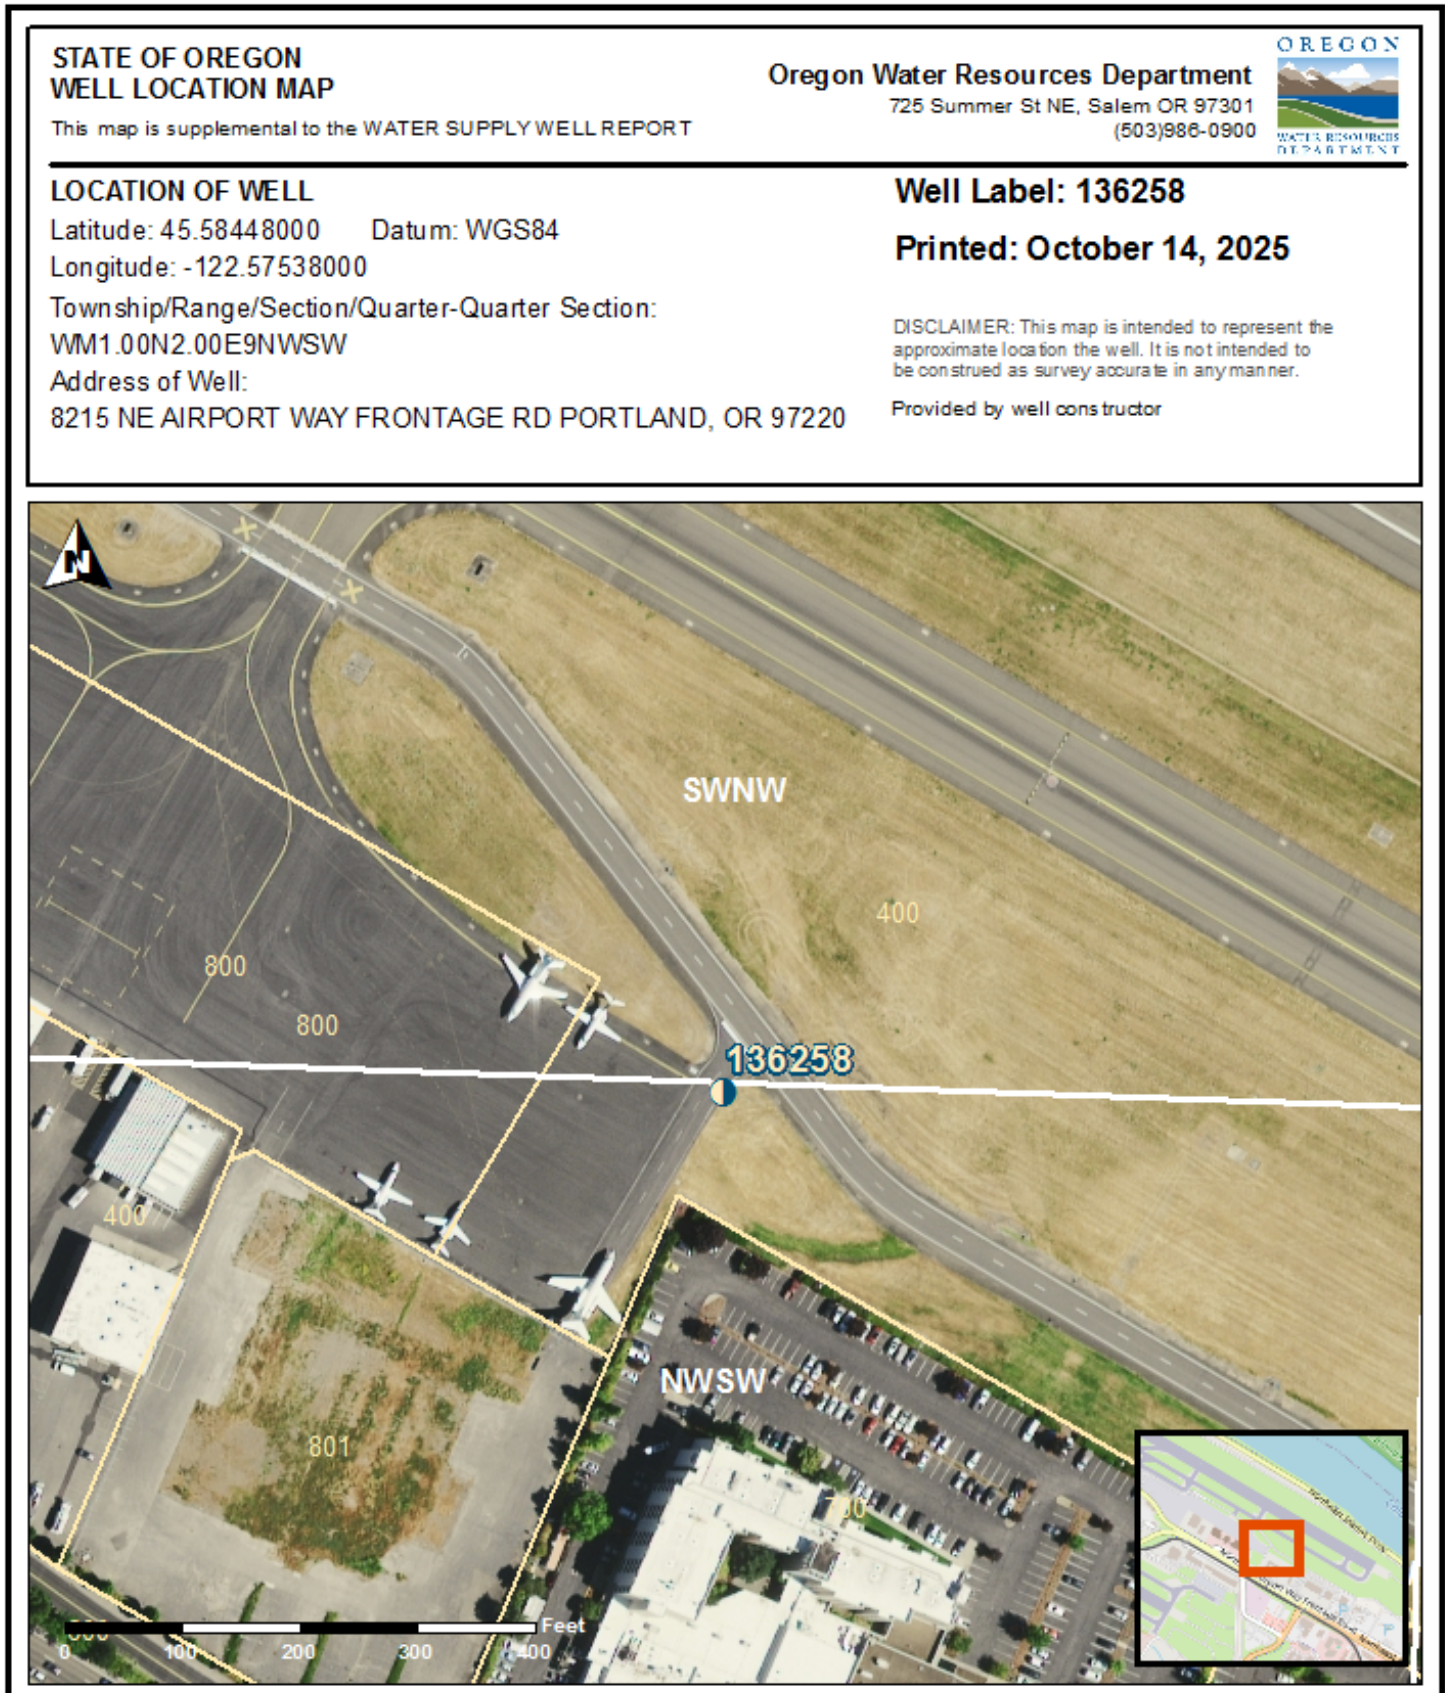

10/14/2025

Map of Hole

INJECTION WELL IW-04 PRELIMINARY AS-BUILT

