


STATE ENGINEER
Salem, Oregon

MULT
001457 Well Record

STATE WELL NO. LN/3-36F
COUNTY Multnomah
APPLICATION NO. GR-4264

OWNER: Jack Watanabe and Kiku Watanabe MAILING ADDRESS: Route 2, Box 1163
CITY AND STATE: Troutdale, Oregon

LOCATION OF WELL: Owner's No. _____
SE 1/4 NW 1/4 Sec. 36 T. 1 N. S. R. 3 W., W.M.
Bearing and distance from section or subdivision
6860 feet
corner North 25° 00' East from SW Corner,
Section 36

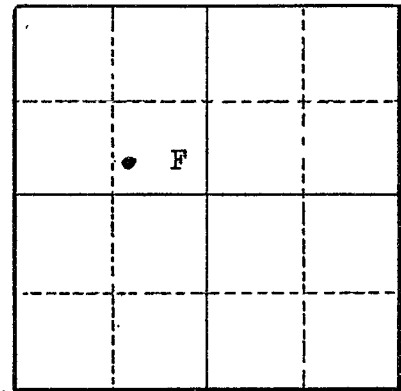

Altitude at well 250 feet

TYPE OF WELL: Drilled Date Constructed May 1935

Depth drilled 60 feet Depth cased 60 feet

Section 36

CASING RECORD:

10-inch casing set from 0 to 60 feet

FINISH:

AQUIFERS:

WATER LEVEL:
50 feet

PUMPING EQUIPMENT: Type Pamona - Little Chief H.P. _____
Capacity 60 G.P.M.

WELL TESTS:
Drawdown 20 ft. after _____ hours 60 G.P.M.
Drawdown _____ ft. after _____ hours _____ G.P.M.

USE OF WATER Irrigation Temp. _____ °F. _____, 19____

SOURCE OF INFORMATION GR-4115

DRILLER or DIGGER A. O. Olson, Gresham, Oregon

ADDITIONAL DATA:
Log (NA) Water Level Measurements _____ Chemical Analysis _____ Aquifer Test _____

REMARKS: