

MULT Well Record

001650

OWNER: Joe V. Caruso


MAILING ADDRESS: 2341 SE Ladd Ave

LOCATION OF WELL: Owner's No.

CITY AND STATE:

NE 1/4 NW 1/4 Sec. 16 T. 2 N. R. 1 W., W.M.

Bearing and distance from section or subdivision corner 850 feet South and 200 feet West from the most easterly corner of the Jacob Cline DLC No. 48

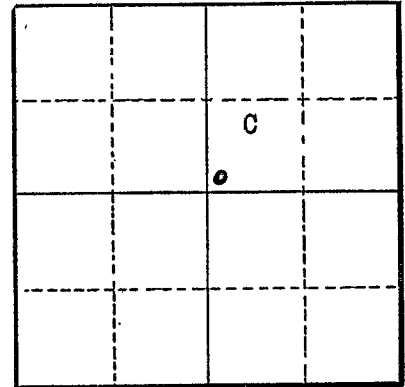

Section 16

Altitude at well

TYPE OF WELL: Drilled Date Constructed June, 1949

Depth drilled 96 feet Depth cased 96 feet

CASING RECORD:

8-inch steel casing set from 0 to 96 feet

FINISH:

5 per ft. 1/2" x 2" long from 83 feet to 94 feet

AQUIFERS:

sand and gravel

WATER LEVEL:

83 feet

PUMPING EQUIPMENT: Type General Electric H.P.
Capacity 600 G.P.M.

WELL TESTS:

Drawdown 1 ft. after 600 hours G.P.M.
Drawdown 0 ft. after 100 hours G.P.M.

USE OF WATER Irrigation Temp. °F. 19

SOURCE OF INFORMATION GR-4108

DRILLER or DIGGER Steinman Bros. McLaughlin Blvd.

ADDITIONAL DATA:

Log Water Level Measurements Chemical Analysis Aquifer Test

REMARKS:

sand some water 1 to 15 feet
fine grey sand 15 to 50 feet
pure grey sand 50 to 66 feet
sand & gravel water bearing 66 to 78 feet
loose gravel water bearing 78 to 85 feet
loose gravel water bearing 85 to 94 feet
loose gravel water bearing 94 to 96 feet