

STATE ENGINEER
Salem, Oregon

MULT
001682

Well Record

STATE WELL NO. 2N/1W-17J
COUNTY MULTNOMAH
APPLICATION NO. GR-2683

OWNER: Gustav Arnold Rick


MAILING ADDRESS: Rt. 1, Box 110-D

LOCATION OF WELL: Owner's No.

CITY AND STATE: Portland 9, Oregon

NE 1/4 SE 1/4 Sec. 17 T. 2 N. S, R. 1 W, W.M.

Bearing and distance from section or subdivision corner 25' northeasterly and 240' northwesterly of most southerly corner of Lot 5, Morgan's Island Acres which will point is 945' West and 270' South of the east quarter corner.

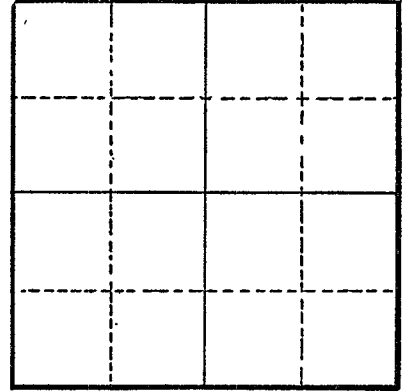

Altitude at well

TYPE OF WELL: drilled Date Constructed 1955

Depth drilled 84 Depth cased 84

Section

CASING RECORD:

6-inch

FINISH:

AQUIFERS:

WATER LEVEL:

32-feet

PUMPING EQUIPMENT: Type Barnes Jet H.P. 1 1/2
Capacity 25 G.P.M.

WELL TESTS:

Drawdown ft. after hours Pumping 25 G.P.M.
Drawdown ft. after hours G.P.M.

USE OF WATER irrigation Temp. °F. 19

SOURCE OF INFORMATION GR-2541

DRILLER or DIGGER Barron and Strayer, Beaverton, Oregon

ADDITIONAL DATA:

Log Water Level Measurements Chemical Analysis Aquifer Test

REMARKS: