

STATE ENGINEER
Salem, Oregon

MULT
001828

Well Record

STATE WELL NO. 2N/1W-35B
COUNTY Multnomah
APPLICATION NO. GR-2699

OWNER: William Shenker & Elizabeth Shenker
dba William Shenker Company

MAILING

ADDRESS: 12005 N. Burgard St.

LOCATION OF WELL: Owner's No. #5


CITY AND
STATE:

Portland, Oregon

SE 1/4 SE 1/4 Sec. 35 T. 2 N. R. 1 E. W.M.

Bearing and distance from section or subdivision

corner 930 ft. W.; 980 ft. N.

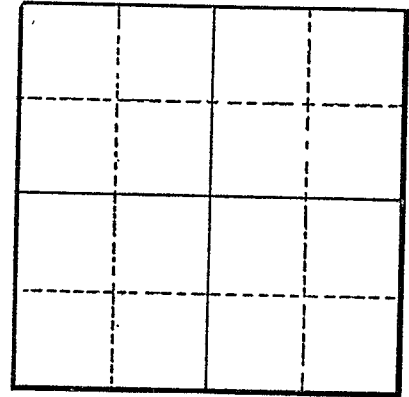

Section

Altitude at well

TYPE OF WELL: Drilled Date Constructed 80'

Depth drilled 90' Depth cased 80'

CASING RECORD:

12 inch

FINISH:

perforated from 70 ft. to 80 ft.

AQUIFERS:

WATER LEVEL:

30 ft.

PUMPING EQUIPMENT: Type Fairbanks Morse

H.P. 30

Capacity 1200 G.P.M.

WELL TESTS:

Drawdown 10 ft. after hours pumping 1000 G.P.M.

Drawdown ft. after hours G.P.M.

USE OF WATER dom., man., and ind. Temp. °F., 19

SOURCE OF INFORMATION GR-2557

DRILLER or DIGGER Janssen Drilling Co., Route 1, Aloha, Oregon

ADDITIONAL DATA:

Log Water Level Measurements Chemical Analysis Aquifer Test

REMARKS:

STATE ENGINEER
Salem, Oregon

State Well No. 2N/1-359

County Multnomah

Application No. _____

Chemical Analysis

OWNER _____ OWNER'S NO. _____

ANALYST USGS Address _____

Date of Collection 4/23/43

Point of Collection _____

	P.P.M.	E.P.M.
Silica (SiO ₂)	48.	
Iron (Fe) Total	.10	
Manganese (Mn)		
Calcium (Ca)	41.	
Magnesium (Mg)	4.3	
Sodium (Na)		
Potassium (K)		
Bicarbonate (HCO ₃)	237.	
Carbonate (CO ₃)		
Sulfate (SO ₄)	12.	
Chloride (Cl)	5.3	
Fluoride (F)	.1	
Nitrate (NO ₃)		
Boron (B)		
Dissolved Solids	284.	
Hardness as CaCO ₃	119.	
Specific Conductance (Micromhos at 25°C)		
pH	6.4	
Percent Sodium		
Sodium Absorption Ratio (S.A.R.)		
CLASS		