

STATE ENGINEER
Salem, Oregon

MULT
001829

Well Record

STATE WELL NO. 2N/1W-35J(3)
COUNTY Multnomah
APPLICATION NO. G-1390

OWNER: Union Carbide


MAILING
ADDRESS: _____

LOCATION OF WELL: Owner's No. 3

CITY AND
STATE: Portland, Oregon

NW $\frac{1}{4}$ SE $\frac{1}{4}$ Sec. 35 T. 2 ~~XS~~ N. 1 ~~W~~, W.M.

Bearing and distance from section or subdivision
corner 1640' N. & 929' W. from SE cor. of sec. 35

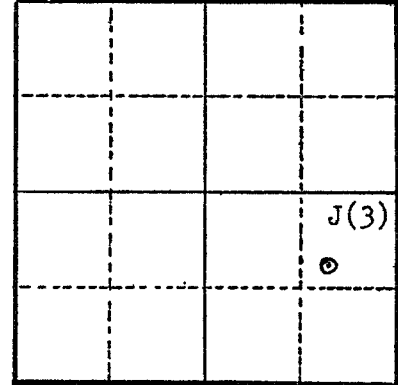

Altitude at well _____

TYPE OF WELL: Drilled Date Constructed 1952

Depth drilled 150' Depth cased 150'

Section 35

CASING RECORD:
12 inch

FINISH:

AQUIFERS:

WATER LEVEL:

PUMPING EQUIPMENT: Type Byron Jackson Subm. H.P. 30
Capacity 700 G.P.M.

WELL TESTS:

Drawdown _____ ft. after _____ hours _____ G.P.M.

Drawdown _____ ft. after _____ hours _____ G.P.M.

USE OF WATER Industrial Temp. _____ °F. _____, 19_____

SOURCE OF INFORMATION G-1294

DRILLER or DIGGER _____

ADDITIONAL DATA:

Log Water Level Measurements _____ Chemical Analysis _____ Aquifer Test _____

REMARKS:

