

MULT
001830

Well Record

STATE WELL NO. 2N/LW-35J(2)
COUNTY Multnomah
APPLICATION NO. G-1390

OWNER: Union Carbide


MAILING
ADDRESS:

LOCATION OF WELL: Owner's No. 2

CITY AND
STATE: Portland, Oregon

NE 1/4 SE 1/4 Sec. 35 T. 2 N. R. 1 W., W.M.

Bearing and distance from section or subdivision
corner 1887' N. & 495' W. from SE cor. of sec. 35

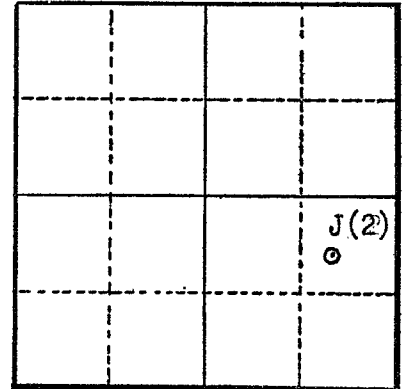

Section 35

Altitude at well

TYPE OF WELL: Drilled Date Constructed 1941

Depth drilled 154' Depth cased 154'

CASING RECORD:
12 inch

FINISH:

AQUIFERS:

Gravel

WATER LEVEL:

PUMPING EQUIPMENT: Type Byron Jackson Subm. H.P. 30
Capacity 700 G.P.M.

WELL TESTS:

Drawdown ft. after hours G.P.M.
Drawdown ft. after hours G.P.M.

USE OF WATER Industrial Temp. °F. 19

SOURCE OF INFORMATION G-1294

DRILLER or DIGGER

ADDITIONAL DATA:

Log Water Level Measurements Chemical Analysis Aquifer Test

REMARKS:

