

STATE ENGINEER
Salem, Oregon

MULT
001831

Well Record

STATE WELL NO. 2N/1W-35J(1)
COUNTY Multnomah
APPLICATION NO. G- 1390

OWNER: Union Carbide

MAILING
ADDRESS:


LOCATION OF WELL: Owner's No. 1

CITY AND
STATE:

Portland, Oregon

NE 1/4 SE 1/4 Sec. 35 T. 2 N. XX R. 1 W., W.M.

Bearing and distance from section or subdivision
corner 1758' N. & 768' W. from SE cor. of sec. 35

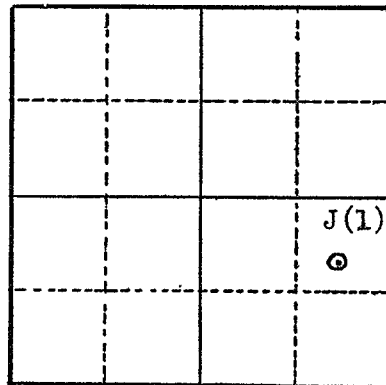

Altitude at well

TYPE OF WELL: Drilled Date Constructed 1941

Depth drilled 152' Depth cased 152'

Section 35

CASING RECORD:
12 inch

FINISH:

AQUIFERS:

Gravel

WATER LEVEL:

PUMPING EQUIPMENT: Type Byron Jackson turbine (subm.?) H.P. 30
Capacity 700 G.P.M.

WELL TESTS:

Drawdown _____ ft. after _____ hours _____ G.P.M.

Drawdown _____ ft. after _____ hours _____ G.P.M.

USE OF WATER Industrial Temp. _____ °F., 19____

SOURCE OF INFORMATION G- 1294

DRILLER or DIGGER _____

ADDITIONAL DATA:

Log X Water Level Measurements _____ Chemical Analysis _____ Aquifer Test _____

REMARKS:

