

STATE ENGINEER
Salem, Oregon

001892 Well Record

STATE WELL NO. 2N/2W-12R
COUNTY Multnomah
APPLICATION NO. GR-3943

OWNER: Rebecca Signor


MAILING ADDRESS: Route 1, Box 287

LOCATION OF WELL: Owner's No. _____

CITY AND STATE: Portland 10, Oregon

SE 1/4 SE 1/4 Sec. 12 T. 2 N. S. R. 2 W., W.M.

Bearing and distance from section or subdivision corner N. 76° 00' W. SE Cor. Sec. 12 200'

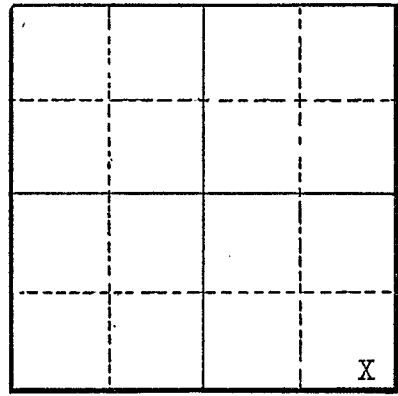

Altitude at well _____

TYPE OF WELL: Drilled Date Constructed Jan., 1953

Depth drilled 152 ft. Depth cased 152 ft.

Section 12

CASING RECORD:

5 inch steel casing set to 152 feet

FINISH:

AQUIFERS:

WATER LEVEL:

80 feet below surface

PUMPING EQUIPMENT: Type Pacific submersible 2" H.P. _____
Capacity 15 G.P.M.

WELL TESTS:

Drawdown 8 ft. after _____ hours 15 G.P.M.
Drawdown _____ ft. after _____ hours _____ G.P.M.

USE OF WATER Irrigation Temp. _____ °F. _____, 19. _____

SOURCE OF INFORMATION Well Registration Statement Cert. # GR-3575

DRILLER or DIGGER _____

ADDITIONAL DATA:

Log Water Level Measurements _____ Chemical Analysis _____ Aquifer Test _____

REMARKS: Log:

	Thickness
Clay	6
Firm sandy silt	74
Blue clay	54
Brown sand	3
Gravel (cement)	3
Sand and gravel	10